LAND CORNER RECORDATION CERTIFICATE

Filing Requirement of Act 74, Mich. P.A. 1970

For corners in GLADWIN (County)

	Located In:	Corner Code ##
1. Public Land Survey	T 20N R 2E	A-7,A-8
	T ___ R ___	
	T ___ R ___	
	T ___ R ___	
2. Property Controlling	S 18 T ___ R ___	15
in Section	S 19 T ___ R ___	10
3. Miscellaneous	S ___ T ___ R ___	
Property in Sec.	S ___ T ___ R ___	

Register of Deeds Stamp & File Number

4. Lot No. _____ , Recorded Plat _____
5. Private Claims _____

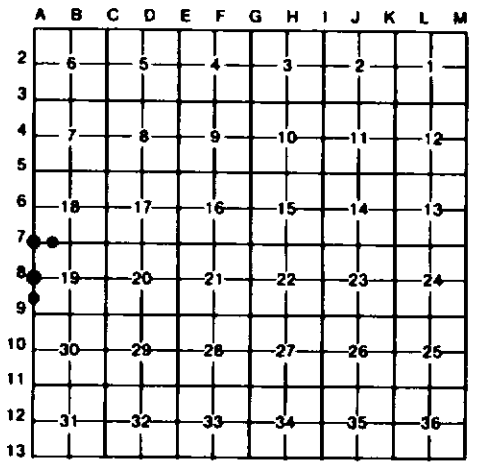

I, CARL T. KIISKILA , in a field survey on DECEMBER 19 , 19 94 , do hereby certify that under requirements of P.A. 74, Michigan P.A. of 1970, the corner points mentioned in lines 1 and 2 above were in conformance with regulations and rules therefore as required in the current manual of survey instructions of the United States Department of the Interior, Bureau of Land Management or by a decree of a Court of Law and/or that the corner points mentioned in lines 3, 4 and 5 above were in conformance with the rules of the Michigan Board of Land Surveyors or by a Decree of a Court of Law; established, re-established, monumented, re-monumented, recovered, found as expressed below:

NOTE: Not more than 4 corners, all in the same town and range, may be recorded on this certificate.

15

STATE OF MICHIGAN
CARL KIISKILA
LAND SURVEYOR
No. 33981
LICENSED LAND SURVEYOR

A. Description of original monument and accessories and/or subsequent restoration:

A-7 A-8 10

(NO EVIDENCE OF G.L.O. CORNER, B.T'S, LINE TREES & TOPOGRAPHY, AS CALLED OUT IN THE G.L.O. LINE NOTES; UNLESS NOTED IN ITEM "B" BELOW.)

B. Description of corner evidence found and/or method applied in restoring or reestablishing corner:

A-7
FOUND AND ACCEPTED 1/2" IRON LOCATED 4' W OF CTR N-S CO. RD. GEORGE HENNING RESTORED THIS COR (SET 1/2" IR. BAR IN OLD CORNER) AS MARKED BY CO. SURVEYOR - JOHN KNOX IN 1908, IN 1966 SURVEY IN NE1/4 OF SEC. 24. G.HENNING HAD ONE KNOX WIT; OLD W.PINE STUMP N47 1/2°W, 49.6'. CTR OF DRIVE W. IS 9' N. CTR OF DRIVE/RD. EAST IS 30' SOUTH.

A-8
REESTABLISHED W 1/4 COR OF SEC 19 MIDWAY AND ON LINE BETWEEN FOUND SECTION CORNERS WHICH AGREES WITH G.HENNING'S SURVEYS DONE IN 1966. CTR OF N-S RD IS 2' EAST.

10
ESTABLISHED THE NW COR OF THE FRL. SW 1/4 OF THE FRACTIONAL SW 1/4 OF SEC 19 BY STANDARD PROCEDURE FOR SUBDIVISION OF A SECTION.

15
FOUND AND ACCEPTED THE SW COR OF THE SE 1/4 OF THE FRACTIONAL SW 1/4 OF SEC 18. SET AND APPARENTLY USED TO LAYOUT PARCELS IN SECTION 19.

C. Description of monument for corner and accessories established to perpetuate locating the position of the corner:

A-7
FD 1/2" IRON 4' W OF CTR RD.
DROVE 1"x 30" PIPE OVER IRON.

14" W. PINE	S29°E	64.98'
POWER POLE	S44°W	40.24'
14" W. PINE	N37°W	62.32'
*TWIN MAPLE	N66°E	44.59'

NO POST SET.
*= J.MEYERS WIT.

A-8
DROVE 5/8" X 32" CAPPED REROD

6" W. PINE	N68°E	58.46'
18" W. PINE	S78°W	46.42'
8" TRI MAPLE	S47°E	43.49'
4" W. BIRCH	N55°W	37.02'
CEDAR POST	WEST	21.68'

ALL TREES HAVE UPPER BLAZE.

10
SET 5/8" X 32" REROD W/CAP IN CTR N-S ROAD.

5" OAK	S46°E	44.07'
24" C.M.P. CHISLED X IN SOUTH END	N37°E	38.94'
5" MAPLE	N51°W	45.71'
2" BALSAM	S62°W	46.98'
CEDAR POST	EAST	33'

15
FD 1/2" REROD N OF BEND IN DRIVE WEST & SOUTH. CTR OF DRIVE EXTENDED WEST IS SOUTH 15.4'.

7" W. PINE	N35°E	21.82'
4" OAK	N50°W	13.10'
POWER POLE	S35°E	38.95'
12" W. PINE	S53°W	65.88'

SET CEDAR POST.

Signed by Carl T Kiiskila Date 1-23-96

Surveyor's Michigan License No. 33981

FORM APPROVED BY MICHIGAN STATE BOARD OF LAND SURVEYORS, JAN. 28, 1971
REVISED MAY 14, 1975
REVISED JAN., 1983