

LAND CORNER RECORDATION CERTIFICATE
Filing Requirement of Act 74, Mich. P.A. 1970

For corners in
GLADWIN
 (County)

Located In: Corner Code ~~##~~

1. Public Land Survey	T <u>20N</u> R <u>2E</u>	<u>A-9, A-10,</u>
	T _____ R _____	<u>A-11</u>
	T _____ R _____	_____
	T _____ R _____	_____
2. Property Controlling in Section	S <u>30</u> T _____ R _____	<u>3</u>
	S _____ T _____ R _____	_____
3. Miscellaneous Property in Sec.	S _____ T _____ R _____	_____
	S _____ T _____ R _____	_____

Register of Deeds Stamp & File Number

4. Lot No. _____, Recorded Plat _____
 5. Private Claims _____


	A	B	C	D	E	F	G	H	I	J	K	L	M
2	6	5	4	3	2	1							
3													
4	7	8	9	10	11	12							
5													
6	18	17	16	15	14	13							
7													
8	19	20	21	22	23	24							
9													
10	30	29	28	27	26	25							
11													
12	31	32	33	34	35	36							
13													

I, CARL T. KIISKILA, in a field survey on NOVEMBER 8, 19 94, do hereby certify that under requirements of P.A. 74, Michigan P.A. of 1970, the corner points mentioned in lines 1 and 2 above were in conformance with regulations and rules therefore as required in the current manual of survey instructions of the United States Department of the Interior, Bureau of Land Management or by a decree of a Court of Law and/or that the corner points mentioned in lines 3, 4 and 5 above were in conformance with the rules of the Michigan Board of Land Surveyors or by a Decree of a Court of Law; established, re-established, monumented, re-monumented, recovered, found as expressed below:

NOTE: Not more than 4 corners, all in the same town and range, may be recorded on this certificate.

A. Description of original monument and accessories and/or subsequent restoration:

A-9	A-10	A-11
(NO EVIDENCE OF G.L.O. CORNER, B.T.'S, LINE TREES & TOPOGRAPHY, AS CALLED OUT IN THE G.L.O. LINE NOTES; UNLESS NOTED IN ITEM "B" BELOW.)		

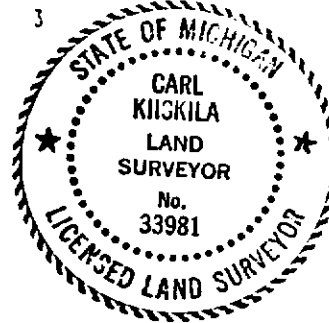

B. Description of corner evidence found and/or method applied in restoring or reestablishing corner:

A-9	A-10	A-11	3
FD & ACCEPTED A LG NAIL FOR THE SW COR S-19. NAIL FITS SURVEYS DONE BY RLS G.HENNING. FD 12" CABIN SPIKE 48.34' N OF THIS COR USED BY J.MEYERS FOR SURVEYS IN S 30. I SHOWED JOHN M. THE INFO WE HAVE FROM G. HENNING. HE AGREED THAT OUR LOC. FOR THE COR COMMON TO SEC 24,25 & 19,30 WAS PROBABLY CORRECT. HE WILL ADJUST HIS SURVEYS TO FIT OUR CORNER.	REESTAB'D W 1/4 COR OF SEC 30 MIDWAY AND ON LINE BETWEEN FD SECTION CORNERS. FOUND P.LAPHAM 1/2" REROD AS SET IN ERROR; N15°59'E, 25.10'. SEE CORNER RECORD A-9. CTR OF ROAD IS 6' EAST.	FD AND ACCEPTED A CAPPED IRON (LS#9433 P.LAPHAM) AT THE INTERSECT OF E-W COUNTY ROAD AND COUNTY ROAD TO NORTH.	ESTABLISHED THE NW COR OF THE FRL SW 1/4 OF THE FRL NW 1/4 OF SEC 30 BY STANDARD PROCEDURE FOR SUBDIVISION OF A SECTION.

C. Description of monument for corner and accessories established to perpetuate locating the position of the corner:

A-9	A-10	A-11	3
FD NAIL, REPLACED WITH 5/8" X 3/2" REROD IN CTR ROAD.	SET CAPPED IRON	FD CAPPED IR ROD IN CO RD INTERSECT.	SET 5/8" X 3/2" REROD W/CAP.
7" OAK S87°E 33.13'	4"-8" MAPLE CLP N58°E 54.11'	POWER POLE S44°W 55.39'	8" W PINE S62°W 34.56'
14" QUAD MAPLE S26°E 54.58'	6" MAPLE S41°E 57.58'	*POWER POLE N40°E 58.07'	14" TRPL OAK N27°W 61.44'
13" TRPL MAPLE N79°W 40.79'	12" W PINE S27°W 70.43'	RD NAME SIGN N38°W 48.69'	14" W PINE N63°E 53.84'
10" POPLAR S63°W 47.43'	8" W PINE N15°W 65.76'	POST N38°W 48.69'	7" TW MAPLE S64°E 44.50'
24" OAK N38°E 73.68'	1/2" REROD N24°E 25.08'	4" SO CONC MON S56°E 74.26'	CEDAR POST EAST 33'
CEDAR POST EAST 26.51'	CEDAR POST WEST 25.5'	W/REROD	
		*=P.LAPHAM WIT.	

Signed by Carl T Kiiskila Date 1-23-96
 Surveyor's Michigan License No. 33981