

AUG 23 2000

SECTION

LAND CORNER RECORDATION CERTIFICATE
Filing Requirement of Act 74, Mich. P.A. 1970
Gladwin County Remonumentation

LIBER 001 PAGE 323

For Corners in
GLADWIN

(County)

Located In:

Corner Code#:

- 1. Public Land Survey T. 20N R. 2W B-7
2. Public Controlling in Section S. T. R.
3. Miscellaneous Property in Section S. T. R.
4. Lot No. Recorded Plat
5. Private Claims

STATE OF MICHIGAN
GLADWIN COUNTY
FILED-REMONUMENTATION

10 AUG 2000 -11:23:30 AM

BONNIE K. HOUSE
REGISTER OF DEEDS

Register of Deeds Stamp & File Number

I, Mark R. Robison, in a field survey on March 2000, do hereby certify that under requirements of P.A. 74, Michigan P.A. of 1970, the corner points mentioned in lines 1 and 2 above were in conformance with regulations and rules therefore as required in the current manual of survey instructions of the United States Department of the Interior, Bureau of Land Management or by a decree of a Court of Law and/or that the corner points mentioned in lines 3, 4 and 5 above were in conformance with the rules of the Michigan Board of Land Surveyors or by a Decree of a Court of Law, established, re-established, monumented, re-monumented, recovered, found as expressed below.

NOTE: Not more than 2 corners, all in the same town and range, may be recorded on this certificate.

Grid table with columns A-M and rows 1-13. Cell (2,6) contains a dot.

A. Description of original monument and accessories and/or subsequent restoration:

- 1856 Geo Adair Set QR. Post Wit-(1)Y. Birch 12 N54E 39 lks (2)W. Ash 8 S37 1/2W 38 lks
1969 Plat of Grass Lake Estates Liber 12, Page 49--Gladwin Co. Records
1992 Lapham LCRC344 survey & wkg dwg Set capped iron from plat of Grass Lake Estates Wit-(3)N80°E, 6" Maple, 12.60' (4)South, 8" Oak, 23.85' (5)West, 6" Maple, 13.20' (6)N05°W, 16" Maple, 42.55'
1998 Lapham wkg dwg / sec subd.

B. Description of corner evidence found and/or method applied in restoring or re-establishing corner:

Found capped iron on brushed line 1286.27 feet West of Plat of Grass Lake Estates and 30 feet West of North-South trail road. Agrees with witnesses recorded in LCRC#344. Accepted found capped iron as corner of record; replaced with 5/8" x 36" roerod.

See dossier for detailed report on corner B-7.


APPROVED LAND CORNER
P.A. 345 of 1990
Gladwin County

Co. Rep. [Signature]
Date 6-15-00

C. Description of monument for corner and accessories established to perpetuate locating the position of the corner:

Set 5/8" x 36" roerod with Gladwin Remonumentation cap marked P.S. 27458. Accepted as best available evidence to perpetuate position of corner B-7.

- Witnesses:
N80°E 6" Maple, nail & tag, 12.60'
South 8" Oak, nail & tag, 23.85'
West 6" Maple, nail & tag, 13.20'
N05°W 16" Maple, nail & tag, 42.55'

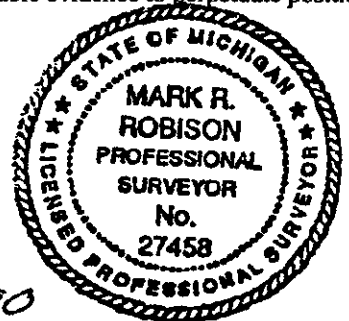

Signed by [Signature]
Surveyor's Michigan License No. 27458

Date 8-9-00