

AUG 23 2000

SECTION

LAND CORNER RECORDATION CERTIFICATE
Filing Requirement of Act 74, Mich. P.A. 1970
Gladwin County Remonumentation

LIBER 001 PAGE 330

For Corners in
GLADWIN

(County)

Located In:

Corner Code#:

- 1. Public Land Survey T. 20N R. 2W C-9
2. Public Controlling in Section S. T. R.
3. Miscellaneous Property in Section S. T. R.
4. Lot No., Recorded Plat
5. Private Claims

STATE OF MICHIGAN
GLADWIN COUNTY
FILED-REMONUMENTATION

10 AUG 2000 11:24:46 AM

BONNIE K. HOUSE
REGISTER OF DEEDS

Register of Deeds Stamp & File Number

I, Mark R. Robison, in a field survey on March 2000, do hereby certify that under requirements of P.A. 74, Michigan P.A. of 1970, the corner points mentioned in lines 1 and 2 above were in conformance with regulations and rules therefore as required in the current manual of survey instructions of the United States Department of the Interior, Bureau of Land Management or by a decree of a Court of Law and/or that the corner points mentioned in lines 3, 4 and 5 above were in conformance with the rules of the Michigan Board of Land Surveyors or by a Decree of a Court of Law, established, re-established, monumented, re-monumented, recovered, found as expressed below.

Grid table with columns A-M and rows 1-13. Cell (2,6) contains '6', (2,5) contains '5', (2,4) contains '4', (2,3) contains '3', (2,2) contains '2', (2,1) contains '1'. Cell (4,7) contains '7', (4,8) contains '8', (4,9) contains '9', (4,10) contains '10', (4,11) contains '11', (4,12) contains '12'. Cell (6,18) contains '18', (6,17) contains '17', (6,16) contains '16', (6,15) contains '15', (6,14) contains '14', (6,13) contains '13'. Cell (8,19) contains '19', (8,20) contains '20', (8,21) contains '21', (8,22) contains '22', (8,23) contains '23', (8,24) contains '24'. Cell (10,30) contains '30', (10,29) contains '29', (10,28) contains '28', (10,27) contains '27', (10,26) contains '26', (10,25) contains '25'. Cell (12,31) contains '31', (12,32) contains '32', (12,33) contains '33', (12,34) contains '34', (12,35) contains '35', (12,36) contains '36'.

NOTE: Not more than 2 corners, all in the same town and range, may be recorded on this certificate.

A. Description of original monument and accessories and/or subsequent restoration:

1856 Geo Adair
Set Post at Cor Sec's 19, 20, 29 & 30
Wit-(1)B. Oak 10 S76 1/2W 27
(2)W. Pine 36 N88 1/2E 7

1993 Erickson
LCRC#350 & working dwg
Set from Lapham witnesses (3), (4),
(5) & (6)

1996 Lapham--survey
Wit-(7)N85°W, 44.45' - N&T in top of
Stump
(8)N55°W, 56.30' - N&T in top of
10" Stump
(9)East, 34.38' - N&T in top of
Fence Post
(10)S30°E 56.20' - N&T in Fence
Post

1992 Lapham--survey & working dwgs
Found Iron
Wit-(3)West, 42.60' - 8" Poplar
(4)N35°W, 58.50' - 12" Maple
(5)N35°E, 61.85' - 6" Oak
(6)S75°E, 45.05' - 16" Poplar

1994 Lapham
survey & working dwg
Found Iron
Wit-same as (3), (4), (5) & (6)

B. Description of corner evidence found and/or method applied in restoring or re-establishing corner:

Found capped iron in centerline of North-South road. Agrees with stumps of Lapham witnesses (3), (4), (5) & (6) and with witnesses (7), (8), (9) & (10). Also agrees with Lapham & Erickson's distances to C-10. Accepted found capped iron as corner of record; replaced with 5/8" x 36" roerod.

See dossier for detailed report on corner C-9.


APPROVED LAND CORNER
P.A. 345 of 1990
Gladwin County

Co. Rep. [Signature]
Date 6-18-00

C. Description of monument for corner and accessories established to perpetuate locating the position of the corner:

Set 5/8" x 36" roerod with Gladwin Remonumentation cap marked P.S. 27458 in Monument Box. Accepted as best available evidence to perpetuate position of corner C-9.

- Witnesses:
N45°E 10" Oak, nail & tag, 62.10'
N85°E Power Pole, nail & tag, 29.61'
S42°E 8" Spruce, nail & tag, 115.25'
S40°W 6" Ash, nail & tag, 86.78'
North & East, P.K. nail, 2.0'

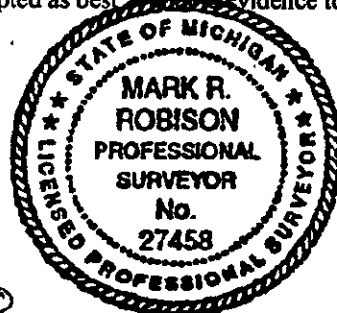

Signed by [Signature]
Surveyor's Michigan License No. 27458

Date 8-9-00