

AUG 23 2000

SECTION LAND CORNER RECORDATION CERTIFICATE
Filing Requirement of Act 74, Mich. P.A. 1970
Gladwin County Remonumentation

118FR 001 PAGE 344

For Corners in
GLADWIN
(County)

Located In: Corner Code#:

- 1. Public Land Survey T. 20N R. 2W K-3
2. Public Controlling in Section S. T. R.
3. Miscellaneous Property in Section S. T. R.
4. Lot No. Recorded Plat
5. Private Claims

STATE OF MICHIGAN
GLADWIN COUNTY
FILED-REMONUMENTATION

10 AUG 2000 11:28:30 AM

RONNIE K. HOUSE
REGISTER OF DEEDS

Register of Deeds Stamp & File Number

I, Mark R. Robison, in a field survey on March 2000, do hereby certify that under requirements of P.A. 74, Michigan P.A. of 1970, the corner points mentioned in lines 1 and 2 above were in conformance with regulations and rules therefore as required in the current manual of survey instructions of the United States Department of the Interior, Bureau of Land Management or by a decree of a Court of Law and/or that the corner points mentioned in lines 3, 4 and 5 above were in conformance with the rules of the Michigan Board of Land Surveyors or by a Decree of a Court of Law, established, re-established, monumented, re-monumented, recovered, found as expressed below.

NOTE: Not more than 2 corners, all in the same town and range, may be recorded on this certificate.

A. Description of original monument and accessories and/or subsequent restoration:

1856 Geo Adair
Set Post at Cor's Sec's 1, 2, 11 & 12
Wit-(1)Hemlock 36 N30E 13 lks
(2)Hemlock 18 S64W 21 lks

1975 Fluharty
LCRC#139 & survey
Fd. 1 1/4" Pipe on W. Edge 2-Way Rd
Intersection
Wit-(5)Cor Fe. Post, S42°E 31.58'
(6)P.P., S39°W, 68.18'
(7)Tele. Box, S61°E 47.52'

1987 Lapham
working drawing

APPROVED LAND CORNER
P.A. 345 of 1990
Gladwin County

Co. Rep. [Signature]
Date 8-2-00

B. Description of corner evidence found and/or method applied in restoring or re-establishing corner:


Found 1 1/4" x 36" B. Pipe, bent on top with rust, West edge East and South road 14" below surface. Also found capped iron 3 feet North and 0.8 feet West of pipe, 0.2 feet below road surface. Both corners fall off driven portion of elevated road--constructed approximately 1 foot above natural ground. 1 1/4" pipe agrees with witnesses (5) & (6). Accepted 1 1/4" pipe (physical appearance & depth of pipe indicate corner was present prior to C.I.; method of setting C.I. by Lapham was weak, i.e. centerline of irregular roads East & South, replaced found 1 1/4" pipe with 5/8" x 36" rerod).

See dossier for detailed report on corner K-3.

C. Description of monument for corner and accessories established to perpetuate locating the position of the corner:

Set 5/8" x 36" rerod with Gladwin Remonumentation cap marked P.S. 27458. Accepted as best available evidence to perpetuate position of corner K-3.

Witnesses:
N35°E 12" Spruce, nail & tag, 63.35'
N65°E Triple 6" Crabapple, nail & tag, 87.65'
S55°W 10" Pine, nail & tag, 59.92'
S30°W Power Pole, nail & tag, 68.45' (OBT)

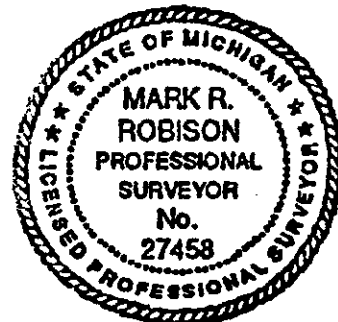

Signed by [Signature] Date 8-9-00
Surveyor's Michigan License No. 27458