

AUG 23 2000

SECTION

LAND CORNER RECORDATION CERTIFICATE
Filing Requirement of Act 74, Mich. P.A. 1970
Gladwin County Remonumentation

001 PAGE 347

For Corners in
GLADWIN
(County)

Located In: Corner Code#:

- 1. Public Land Survey T. 20N R. 2W M-1
2. Public Controlling in Section S. T. R.
3. Miscellaneous Property in Section S. T. R.
4. Lot No. Recorded Plat
5. Private Claims

STATE OF MICHIGAN
GLADWIN COUNTY
FILED-REMONUMENTATION

10 AUG 2000 11:29:04 AM

BONNIE K. HOUSE
REGISTER OF DEEDS

Register of Deeds Stamp & File Number

I, Mark R. Robison, in a field survey on March 2000, do hereby certify that under requirements of P.A. 74, Michigan P.A. of 1970, the corner points mentioned in lines 1 and 2 above were in conformance with regulations and rules therefore as required in the current manual of survey instructions of the United States Department of the Interior, Bureau of Land Management or by a decree of a Court of Law and/or that the corner points mentioned in lines 3, 4 and 5 above were in conformance with the rules of the Michigan Board of Land Surveyors or by a Decree of a Court of Law, established, re-established, monumented, re-monumented, recovered, found as expressed below.

Grid table with columns A-M and rows 1-13 containing numbers 1-36.

NOTE: Not more than 2 corners, all in the same town and range, may be recorded on this certificate.

A. Description of original monument and accessories and/or subsequent restoration:

- 1838 Nicholson South side Sec 36 from post cor of twp T21N, R1&2W Wit-(1)Y. Pine 16 S38E 77 (2)Do 20 S83E 83
1966 County Road Plans Found 1/2" Steel Rod Wit-(7)N75°W 70.48 Steel Hwy Sign (8)N45°E 45.20 Cor. Fe. Post (9)S45°E 33.45 Cor. Fe. Post (10)West 356.30 Cor. Sec's 36-31 Roscommon Co.
1950+/- G. Dundas Found wood stake, Set iron Wit-(3)P. Pole SW 132 (4)P. Pole SE 70.8 (5)NW Bailey Store 70.4 (6)356.3 West, Roscommon Corner
1988 Lapham survey & working dwg Wit-none

1990 Cavanagh-survey Roscommon County

APPROVED LAND CORNER
P.A. 345 of 1990
Gladwin County

Co. Rep. [Signature]
Date 6-12-00

B. Description of corner evidence found and/or method applied in restoring or re-establishing corner:


Found 5/8" x 8" rerod in 1 1/4" pipe and 1/2" rod with some decayed wood fragments in centerline East-West road and centerline of road to South extended. Agrees with witnesses (4)Recorded 70.8', measured 70.00' and (9)Recorded 33.45', measured 33.5'+/- when post is reconstructed in upright position. Also agrees with measurement of 356.10' to town corner Southwest Corner Section 36, T21N, R2W, by Dundas (1950), County road plans (1968) and Lapham (1988 & 2000). Accepted found 1 1/4" pipe as corner of record.

See dossier for detailed report on corner M-1.

C. Description of monument for corner and accessories established to perpetuate locating the position of the corner:

Set Gladwin Remonumentation cap marked P.S. 27458 on found 1 1/4" pipe. Accepted as best available evidence to perpetuate position of corner M-1.

- Witnesses:
S45°E Power Pole, nail & tag, 70.00'
N15°W Power Pole, nail & tag, 97.20'
N68°E 6" Cluster Box Elders, nail & tag, 145.00'
West-Roscommon County Remon, SW Corner Section 36, T21N, R2W, 356.10'

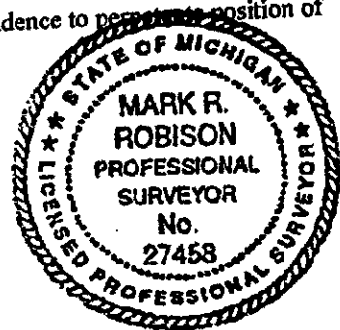

Signed by [Signature]
Surveyor's Michigan License No. 27458

Date 8-9-00