

**SURVEY &
REMONUMENTATION**

GLADWIN COUNTY REMONUMENTATION

DEC 16 1996

LAND CORNER RECORDATION CERTIFICATE
Filing Requirement of Act 74, Mich. P.A. 1970

COMMISSION

LIBER 001 PAGE 103

For corners in

GLADWIN (County)	Located In:	Corner Code #
1. Public Land Survey	T <u>20N</u> R <u>2W</u>	<u>M - 5</u>
	T <u> </u> R <u> </u>	<u> </u>
	T <u> </u> R <u> </u>	<u> </u>
	T <u> </u> R <u> </u>	<u> </u>
2. Property Controlling in Section	S <u> </u> T <u> </u> R <u> </u>	<u> </u>
	S <u> </u> T <u> </u> R <u> </u>	<u> </u>
3. Miscellaneous Property in Sec.	S <u> </u> T <u> </u> R <u> </u>	<u> </u>
	S <u> </u> T <u> </u> R <u> </u>	<u> </u>

STATE OF MICHIGAN
GLADWIN COUNTY
FILED - CORNER

2 DEC 96 3:23 P.M.

BONNIE K. HOUSE
REGISTER OF DEEDS
Register of Deeds Stamp & File Number

4. Lot No. _____, Recorded Plat _____
5. Private Claims _____

I, MARK ROBISON, in a field survey on November, 19 96 do hereby state that under requirements of P.A. 74, Michigan P.A. of 1970, the corner points mentioned in lines 1 and 2 above were in conformance with regulations and rules therefore as required in the current manual of survey instructions of the United States Department of the Interior, Bureau of Land Management or by a decree of a Court of Law and /or that the corner points mentioned in lines 3, 4 and 5 above were in conformance with the rules of the Michigan Board of Land Surveyors or by a Decree of a Court of Law; established, re-established, monumented, recovered, found as expressed below:

NOTE: Not more than 2 corners, all in the same town and range, may be recorded on this certificate.

	A	B	C	D	E	F	G	H	I	J	K	L	M
1													
2	6		5		4		3		2		1		
3													
4	7		8		9		10		11		12		
5													
6	18		17		16		15		14		13		
7													
8	19		20		21		22		23		24		
9													
10	30		29		28		27		26		25		
11													
12	31		32		33		34		35		36		
13													

A. Description of original monument and accessories and/or subsequent restoration:

- | | | |
|--|---|---|
| 1956 GEO ADAIR SET POST | (9)SW 56.95 TO NAIL IN SE SIDE 26" CEDAR | WIT.-(13)S61W 45.91 TELE POLE |
| WIT.-(1)CEDAR 10 S6W 48 | 1963 P LAPHAM FOUND 1/2" R. STEEL WIT.-NONE | (14)S56E 63.43 POWER POLE |
| (2)HEMLOCK 10 S45E 22 | 1963 GLADWIN COUNTY ROAD PLANS | (15)N49E 77.25 |
| 1960+/- DUNDAS & EDMANDS ENG. | FOUND 1/2" PIPE WIT.-SAME AS (3),(4)&(5) | 1989 P LAPHAM SURVEY FD 3/4" BAR |
| WITS WORKING DWG & SEC SUBD FD 3/4" IRON ROD | 1969 PAUL LAPHAM SURVEY | WIT.-SAME AS (13)&(14) |
| WIT.-(3)N45W 42.53 SIGN POST | 1976 FLUHARTY-L.C.R.C.#139 | 1989 P LAPHAM-WORKING DWG & SEC SUBD |
| (4)N45E 76.80 JCT POLE | FOUND 3/4" BAR 10.8 WEST OF C/L | 1992 P LAPHAM SVY WIT.-SAME AS (13),(14)&(15) |
| (5)S48E 38.50 COR FE. POST | WIT.-(10)T.P. S61W 45.91 | 1993 MYERS-SEC SUBD. WIT.-NONE |
| (6)NE 77.45 NAIL IN NW SIDE P.P. | (11)P.P. S56E 63.43 | 1993 P LAPHAM SVY WIT.-SAME AS (13)&(14) |
| (7)SE 81.35 NAIL IN SW SIDE P.P. | (12)P.P. N49E 77.25 | |
| (8)NW 81.60 NAIL IN NE SIDE 5" CEDAR | 1979 SEDGEMAN SURVEY FOUND 3/4" BAR | |

B. Description of corner evidence found and/or method applied in restoring or reestablishing corner:

FOUND 3/4" IRON BAR IN C/L OF EAST & WEST ROAD, 11' WEST OF C/L NORTH & SOUTH ROAD. FOUND (6), NAIL; MEAS. 77.48, REC. 77.45. FOUND (7), N&T; MEAS. 81.40, REC. 81.35. FOUND (9), NAIL; MEAS. 57.10, REC. 56.95. SET GLADWIN RE-MON FROM FOUND IRON & WITNESSES.

APPROVED LAND CORNER
P.A. 375 of 1980
Gladwin County


SEE DOSSIER FOR DETAILED REPORT.

Co. Rep. [Signature]
Date 11/6/96

C. Description of monument for corner and accessories established to perpetuate locating the position of the corner:

M-5: SE CORNER OF SECTION 12
SET 5/8" X 36" REROD WITH GLADWIN RE-MON CAP MARKED P.S.#27458

- WITNESSES:
N45E POWER POLE, N&T, 77.48'
S45E POWER POLE, N&T, 81.40'
S40W 26" CEDAR STUB, SPIKE, 57.10'
S70W FORK 5" SPRUCE, N&T, 73.10'

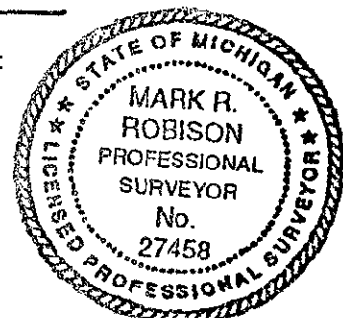

Signed by Mark R. Robison
Surveyor's Michigan License No. 27458

Date 11-29-96