

DEC 16 1996

COMMISSION

GLADWIN COUNTY REMONUMENTATION

LAND CORNER RECORDATION CERTIFICATE  
Filing Requirement of Act 74, Mich. P.A. 1970

LIBER 001 PAGE 105

For corners in

<u>GLADWIN</u> (County)	Located In:	Corner Code #
1. Public Land Survey	T <u>20N</u> R <u>2W</u>	<u>M - 11</u>
	T <u>    </u> R <u>    </u>	<u>    </u>
	T <u>    </u> R <u>    </u>	<u>    </u>
	T <u>    </u> R <u>    </u>	<u>    </u>
2. Property Controlling in Section	S <u>    </u> T <u>    </u> R <u>    </u>	<u>    </u>
	S <u>    </u> T <u>    </u> R <u>    </u>	<u>    </u>
3. Miscellaneous Property in Sec.	S <u>    </u> T <u>    </u> R <u>    </u>	<u>    </u>
	S <u>    </u> T <u>    </u> R <u>    </u>	<u>    </u>

STATE OF MICHIGAN  
GLADWIN COUNTY  
FILED-REMONUMENTATION

2 DEC 96 3:23 P.M.

BONNIE K. HOUSE  
REGISTER OF DEEDS

Register of Deeds Stamp & File Number

4. Lot No. \_\_\_\_\_, Recorded Plat \_\_\_\_\_  
5. Private Claims \_\_\_\_\_

I, MARK ROBISON, in a field survey on November, 1996 do hereby state that under requirements of P.A. 74, Michigan P.A. of 1970, the corner points mentioned in lines 1 and 2 above were in conformance with regulations and rules therefore as required in the current manual of survey instructions of the United States Department of the Interior, Bureau of Land Management or by a decree of a Court of Law and /or that the corner points mentioned in lines 3, 4 and 5 above were in conformance with the rules of the Michigan Board of Land Surveyors or by a Decree of a Court of Law; established, re-established, monumented, recovered, found as expressed below:

NOTE: Not more than 2 corners, all in the same town and range, may be recorded on this certificate.

1	A	B	C	D	E	F	G	H	I	J	K	L	M
2		6		5		4		3		2		1	
3													
4		7		8		9		10		11		12	
5													
6		10		17		16		15		14		13	
7													
8		19		20		21		22		23		24	
9													
10		30		29		28		27		26		25	
11													
12		31		32		33		34		35		36	
13													

A. Description of original monument and accessories and/or subsequent restoration:

- |   |   |  |
|---|---|--|
| 1956 GEO E. ADAIR<br>SET POST<br>WIT.-(1)MAPLE 8 N38W 05<br>(2)MAPLE 10 S5W 30<br>1974 PAUL LAPHAM L.C.R.C.#96<br>SET CAPPED IRON<br>WIT.-(3)S20E 13.38 4" WILLOW<br>(4)NORTH 28.00 COR FE POST<br>(5)N40W 27.45 14" WILLOW<br>1974 PAUL LAPHAM<br>WIT.-SAME AS (3),(4)&(5) | 1978 PAUL LAPHAM<br>WIT.-SAME AS (3),(4)&(5)<br>1979 PAUL LAPHAM-SECTION SUBD.<br>WIT.-NONE<br>1980 PAUL LAPHAM<br>WIT.-SAME AS (3),(4)&(5)<br>1986 PAUL LAPHAM<br>WIT.-SAME AS (3),(4)&(5)<br>1989 PAUL LAPHAM<br>WIT.-SAME AS (3),(4)&(5)<br>1991 PAUL LAPHAM | WIT.-SAME AS (3),(4)&(5)<br>1995 PAUL LAPHAM<br>WIT.-SAME AS (3),(4)&(5)<br>1996 PAUL LAPHAM SURVEY<br>FOUND CAPPED IRON<br>WIT.-(6)NORTH 28.6 FD N&T IN<br>COR FE POST<br>(7)N35E 33.28, SPIKE, 6" ELM<br>(8)S10E 13.22, SPIKE, 12" WILLOW<br>(9)N75W 11.11, SPIKE, 10" ELM |
|---|---|--|

B. Description of corner evidence found and/or method applied in restoring or reestablishing corner:

FOUND CI #18664 OPPOSITE FENCE (POOR CONDITION) TO NORTH. FOUND (3); MEAS. 13.22, REC. 13.39. FOUND (4); MEAS. 28.6, REC. 28.0. SET GLADWIN RE-MON IN PLACE OF CI.

SEE DOSSIER FOR DETAILED REPORT.


APPROVED LAND CORNER  
P.A. 745 of 1000  
Gladwin County

Co. Rep. Mark Robison  
Date 11/6/96

C. Description of monument for corner and accessories established to perpetuate locating the position of the corner:

M-11: SE CORNER OF SECTION 25  
SET 5/8" X 3/8" REROD WITH GLADWIN RE-MON CAP MARKED P.S.#27458

WITNESSES:  
NORTH 28.6 FD N&T IN COR FE POST  
N35E 33.28, SPIKE, 6" ELM  
S10E 13.22, SPIKE, 12" WILLOW  
N75W 11.11, SPIKE, 10" ELM

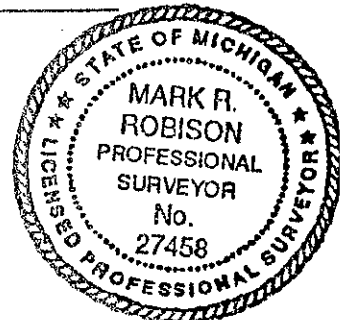

Signed by Mark R. Robison  
Surveyor's Michigan License No. 27458

Date 11-29-96