

DEC 16 1996

COMMISSION

GLADWIN COUNTY REMONUMENTATION

LAND CORNER RECORDATION CERTIFICATE
Filing Requirement of Act 74, Mich. P.A. 1970

LIBER 001 PAGE 128

STATE OF MICHIGAN
GLADWIN COUNTY
FILED-REMONUMENTATION

2 DEC 96 3:29 P.M.

BONNIE K. HOUSE
REGISTER OF DEEDS

Register of Deeds Stamp & File Number

For corners in

GLADWIN

(County)

Located In:

Corner Code #

1. Public Land Survey

T 20N R 1W A - 5
T R
T R
T R

2. Property Controlling in Section

S T R
S T R

3. Miscellaneous

S T R

Property in Sec.

S T R

4. Lot No. , Recorded Plat

5. Private Claims

I, MARK ROBISON, in a field survey on November, 19 96 do hereby state that under requirements of P.A. 74, Michigan P.A. of 1970, the corner points mentioned in lines 1 and 2 above were in conformance with regulations and rules therefore as required in the current manual of survey instructions of the United States Department of the Interior, Bureau of Land Management or by a decree of a Court of Law and/or that the corner points mentioned in lines 3, 4 and 5 above were in conformance with the rules of the Michigan Board of Land Surveyors or by a Decree of a Court of Law; established, re-established, monumented, recovered, found as expressed below:

NOTE: Not more than 2 corners, all in the same town and range, may be recorded on this certificate.

Grid table with columns A-M and rows 1-13. Contains numbers 1-36 in a grid pattern.

A. Description of original monument and accessories and/or subsequent restoration:

- 1856 GEO ADAIR SET POST
WIT.-(1)CEDAR 10 S6W 48
(2)HEMLOCK 10 S45E 22
1980+J. DUNDAS & EDMANDS ENG.
WIT-WORKING DWG & SEC SUBD. FOUND 3/4" IRON
WIT.-(3)N45W 42.53 SIGN POST
(4)N45E 78.80 JCT POLE
(5)S48E 38.50 COR FE. POST
(6)NE 77.45 NAIL IN NW SIDE P.P.
(7)SE 81.35 NAIL IN SW SIDE P.P.
(8)NW 81.80 NAIL IN NE SIDE 5" CEDAR

- WIT.-(13)S61W 45.91 TELE POLE
(14)S56E 83.43 POWER POLE
(15)N49E 77.25 POWER POLE
1989 PAUL LAPHAM SURVEY FD 3/4" BAR
WIT.-SAME AS (13)&(14)
1989 PAUL LAPHAM-WORKING DRAWING & SECT
1992 PAUL LAPHAM SURVEY
WIT.-SAME AS (13),(14)&(15)
1993 MYERS-SECTION SUBD. WIT.-NONE
1993 PAUL LAPHAM SURVEY
WIT.-SAME AS (13)&(14)

B. Description of corner evidence found and/or method applied in restoring or reestablishing corner:

FOUND 3/4" IRON BAR IN C/L OF EAST & WEST ROAD, 11' WEST OF C/L NORTH & SOUTH ROAD. FOUND (6), NAIL; MEAS. 77.48, REC. 77.45. FOUND (7), N&T; MEAS. 81.40, REC. 81.35. FOUND (9), NAIL; MEAS. 57.10, REC. 56.85. SET GLADWIN RE-MON FROM FOUND IRON & WITNESSES.

APPROVED LAND CORNER

P.A. 375 of 1980

Gladwin County

SEE DOSSIER FOR DETAILED REPORT.


Co. Rep. [Signature]

Date 11/6/96

C. Description of monument for corner and accessories established to perpetuate locating the position of the corner:

A-5: SW CORNER OF SECTION 7
SET 5/8" X 3/8" REROD WITH GLADWIN RE-MON CAP MARKED P.S.#27458

- WITNESSES:
N45E POWER POLE, N&T, 77.48'
S45E POWER POLE, N&T, 81.40'
S40W 26" CEDAR STUB, SPIKE, 57.10'
S70W FORK 5" SPRUCE, N&T, 73.10'

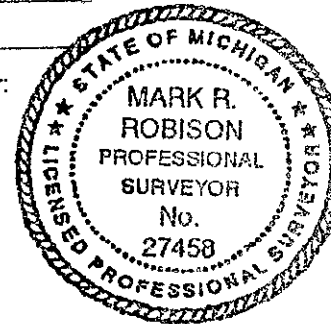

Signed by [Signature]

Date 11-29-96

Surveyor's Michigan License No. 27458