

SURVEY & REMONUMENTATION

DEC 16 1996

GLADWIN COUNTY REMONUMENTATION

COMMISSION

LAND CORNER RECORDATION CERTIFICATE
Filing Requirement of Act 74, Mich. P.A. 1970

LIBER **001** PAGE **129**

For corners in

GLADWIN (County)	Located In:	Corner Code #
1. Public Land Survey	T 20N R 1W	A - 10
	T R	
	T R	
	T R	
2. Property Controlling in Section	S T R	
	S T R	
3. Miscellaneous Property in Sec.	S T R	
	S T R	

STATE OF MICHIGAN
GLADWIN COUNTY
FILED-REMONUMENTATION

2 DEC 96 3:29 P.M.

BONNIE K. HOUSE
REGISTER OF DEEDS

Register of Deeds Stamp & File Number

4. Lot No. _____, Recorded Plat _____
5. Private Claims _____

I, MARK ROBISON, in a field survey on November, 1996 do hereby state that under requirements of P.A. 74, Michigan P.A. of 1970, the corner points mentioned in lines 1 and 2 above were in conformance with regulations and rules therefore as required in the current manual of survey instructions of the United States Department of the Interior, Bureau of Land Management or by a decree of a Court of Law and /or that the corner points mentioned in lines 3, 4 and 5 above were in conformance with the rules of the Michigan Board of Land Surveyors or by a Decree of a Court of Law; established, re-established, monumented, recovered, found as expressed below:

NOTE: Not more than 2 corners, all in the same town and range, may be recorded on this certificate.

	A	B	C	D	E	F	G	H	I	J	K	L	M
1													
2	6		5		4		3		2		1		
3													
4	7		8		9		10		11		12		
5													
6	10		17		16		15		14		13		
7													
8	19		20		21		22		23		24		
9													
10	30		29		28		27		26		25		
11													
12	31		32		33		34		35		36		
13													

A. Description of original monument and accessories and/or subsequent restoration:

1856 GEO E. ADAIR
SET 1/4 POST
WIT.-(1) ASPEN 6 S14W 23
(2) CEDAR 6 N18W 17

1975 PAUL LAPHAM-SECTION SUBD.
WIT.-NONE

1980 PAUL LAPHAM SURVEY
WIT.-SAME AS (7),(8)&(9)

1964 GLADWIN CO. RD. PLANS
TEE IRON
WIT.-(3)N35E 58.9 FE. POST
(4)EAST 33.0 COR POST
(5)S45E 45.7 FE. POST
APPROX. 1/4 COR.

1975 PAUL LAPHAM L.C.R.C.#137
FOUND SUCKER ROD
WIT.-(7)EAST 33.01 COR POST
(8)S70E 42.82 2nd POST SOUTH
(9)S85W 56.70 TELE ROUTE MARKER

B. Description of corner evidence found and/or method applied in restoring or reestablishing corner:

FOUND 12" SUCKER ROD 25' EAST OF C/L OF CURVE IN ROAD ON C/L OF NORTH ROAD EXTENDED SOUTH, OPPOSITE FENCES EAST & WEST. FOUND (7), N&T; REC. 33.01, MEAS. 33.11. FOUND (8), N&T; REC. 42.82, MEAS. 42.78. SET GLADWIN RE-MON IN PLACE OF FOUND SUCKER ROD.

APPROVED LAND CORNER
P.A. 745 of 1990
Gladwin County


SEE DOSSIER FOR DETAILED REPORT.

Co. Rep. [Signature]
Date 11/6/96

C. Description of monument for corner and accessories established to perpetuate locating the position of the corner:

A-10: WEST 1/4 CORNER OF SECTION 30
SET 5/8" X 36" REROD WITH GLADWIN RE-MON CAP MARKED P.S.#27458

WITNESSES:
EAST POWER POLE, N&T, 37.83'
S50E 3" MAPLE, N&T, 98.20'
WEST C/L ROAD, P.K. NAIL, 24.83'
EAST COR POST, N&T, 33.11'
S70E 2nd POST SOUTH

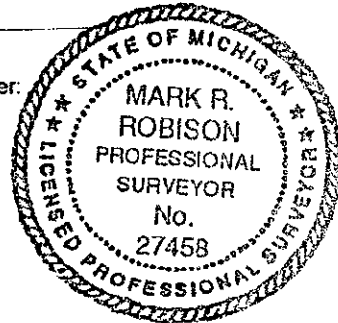

Signed by Mark R. Robison
Surveyor's Michigan License No. 27458

Date 11-29-96