

**SURVEY &
REMONUMENTATION**

DEC 16 1996

COMMISSION

GLADWIN COUNTY REMONUMENTATION

LAND CORNER RECORDATION CERTIFICATE
Filing Requirement of Act 74, Mich. P.A. 1970

LIBER **001** PAGE **130**

For corners in

<u>GLADWIN</u> (County)	Located In:	Corner Code #
1. Public Land Survey	T <u>20N</u> R <u>1W</u>	<u>A - 11</u>
	T <u> </u> R <u> </u>	<u> </u>
	T <u> </u> R <u> </u>	<u> </u>
	T <u> </u> R <u> </u>	<u> </u>
2. Property Controlling in Section	S <u> </u> T <u> </u> R <u> </u>	<u> </u>
	S <u> </u> T <u> </u> R <u> </u>	<u> </u>
3. Miscellaneous Property in Sec.	S <u> </u> T <u> </u> R <u> </u>	<u> </u>
	S <u> </u> T <u> </u> R <u> </u>	<u> </u>

STATE OF MICHIGAN
GLADWIN COUNTY
FILED-REMONUMENTATION

2 DEC 96 3:29 P.M.

BONNIE K. HOUSE
REGISTER OF DEEDS

Register of Deeds Stamp & File Number

4. Lot No. _____, Recorded Plat _____
5. Private Claims _____

I, MARK ROBISON, in a field survey on November, 19 96 do hereby state that under requirements of P.A. 74, Michigan P.A. of 1970, the corner points mentioned in lines 1 and 2 above were in conformance with regulations and rules therefore as required in the current manual of survey instructions of the United States Department of the Interior, Bureau of Land Management or by a decree of a Court of Law and /or that the corner points mentioned in lines 3, 4 and 5 above were in conformance with the rules of the Michigan Board of Land Surveyors or by a Decree of a Court of Law; established, re-established, monumented, recovered, found as expressed below:

NOTE: Not more than 2 corners, all in the same town and range, may be recorded on this certificate.

	A	B	C	D	E	F	G	H	I	J	K	L	M
1													
2	6		5		4		3		2		1		
3													
4	7		8		9		10		11		12		
5													
6	18		17		16		15		14		13		
7													
8	19		20		21		22		23		24		
9													
10	30		29		28		27		26		25		
11													
12	31		32		33		34		35		36		
13													

A. Description of original monument and accessories and/or subsequent restoration:

- | | | |
|---|---|--|
| 1856 GEO E. ADAIR
SET POST
WIT.-(1)MAPLE 8 N36W 05
(2)MAPLE 10 S5W 30
1974 PAUL LAPHAM L.C.R.C.#96
SET CAPPED IRON
WIT.-(3)S20E 13.39 4" WILLOW
(4)NORTH 28.00 COR FE POST
(5)N40W 27.45 14" WILLOW
1974 PAUL LAPHAM
WIT.-SAME AS (3),(4)&(5) | 1978 PAUL LAPHAM
WIT.-SAME AS (3),(4)&(5)
1979 PAUL LAPHAM-SECTION SUBD.
WIT.-NONE
1980 PAUL LAPHAM
WIT.-SAME AS (3),(4)&(5)
1986 PAUL LAPHAM
WIT.-SAME AS (3),(4)&(5)
1989 PAUL LAPHAM
WIT.-SAME AS (3),(4)&(5)
1991 PAUL LAPHAM | WIT.-SAME AS (3),(4)&(5)
1995 PAUL LAPHAM
WIT.-SAME AS (3),(4)&(5)
1996 PAUL LAPHAM SURVEY
FOUND CAPPED IRON
WIT.-(6)NORTH 28.6 FD N&T IN
COR FE POST
(7)N35E 33.28, SPIKE, 6" ELM
(8)S10E 13.22, SPIKE, 12" WILLOW
(9)N75W 11.11, SPIKE, 10" ELM |
|---|---|--|

B. Description of corner evidence found and/or method applied in restoring or reestablishing corner:

FOUND CI #18664 OPPOSITE FENCE (POOR CONDITION) TO NORTH. FOUND (3); MEAS. 13.22, REC. 13.39. FOUND (4); MEAS. 28.6, REC. 28.0. SET GLADWIN RE-MON IN PLACE OF CI.

APPROVED LAND CORNER

P.A. 345 of 1990

Gladwin County

SEE DOSSIER FOR DETAILED REPORT.


Co. Rep. John M. Myers

Date 11/6/96

C. Description of monument for corner and accessories established to perpetuate locating the position of the corner:

A-11: SW CORNER OF SECTION 30
SET 5/8" X 36" REROD WITH GLADWIN RE-MON CAP MARKED P.S.#27458

WITNESSES:
NORTH 28.6 FD N&T IN COR FE POST
N35E 33.28, SPIKE, 6" ELM
S10E 13.22, SPIKE, 12" WILLOW
N75W 11.11, SPIKE, 10" ELM

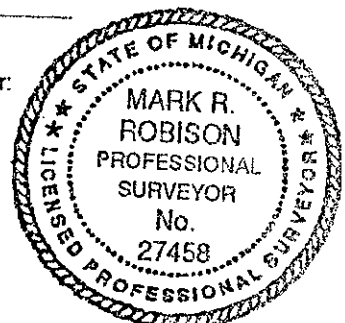

Signed by Mark R. Robison

Date 11-29-96

Surveyor's Michigan License No. 27458