

DEC 16 1996

COMMISSION

GLADWIN COUNTY REMONUMENTATION

LAND CORNER RECORDATION CERTIFICATE  
Filing Requirement of Act 74, Mich. P.A. 1970

LIBER 001 PAGE 133

For corners in

GLADWIN (County)	Located In:	Corner Code #
1. Public Land Survey	T <u>20N</u> R <u>1W</u>	<u>B - 9</u>
	T <u>    </u> R <u>    </u>	<u>    </u>
	T <u>    </u> R <u>    </u>	<u>    </u>
	T <u>    </u> R <u>    </u>	<u>    </u>
2. Property Controlling in Section	S <u>    </u> T <u>    </u> R <u>    </u>	<u>    </u>
	S <u>    </u> T <u>    </u> R <u>    </u>	<u>    </u>
3. Miscellaneous Property in Sec.	S <u>    </u> T <u>    </u> R <u>    </u>	<u>    </u>
	S <u>    </u> T <u>    </u> R <u>    </u>	<u>    </u>

STATE OF MICHIGAN  
GLADWIN COUNTY  
FILED-REMONUMENTATION

2 DEC 96 3:30 P.M.

BONNIE K. HOUSE  
REGISTER OF DEEDS

Register of Deeds Stamp & File Number

4. Lot No. \_\_\_\_\_, Recorded Plat \_\_\_\_\_  
5. Private Claims \_\_\_\_\_

I, MARK ROBISON, in a field survey on December, 1996, do hereby state that under requirements of P.A. 74, Michigan P.A. of 1970, the corner points mentioned in lines 1 and 2 above were in conformance with regulations and rules therefore as required in the current manual of survey instructions of the United States Department of the Interior, Bureau of Land Management or by a decree of a Court of Law and /or that the corner points mentioned in lines 3, 4 and 5 above were in conformance with the rules of the Michigan Board of Land Surveyors or by a Decree of a Court of Law; established, re-established, monumented, recovered, found as expressed below:

NOTE: Not more than 2 corners, all in the same town and range, may be recorded on this certificate.

	A	B	C	D	E	F	G	H	I	J	K	L	M
1													
2		6		5		4		3		2		1	
3													
4		7		8		9		10		11		12	
5													
6		18		17		16		15		14		13	
7													
8		19		20		21		22		23		24	
9		●											
10		30		29		28		27		26		25	
11													
12		31		32		33		34		35		36	
13													

A. Description of original monument and accessories and/or subsequent restoration:

1856 GEO E. ADAIR  
SET 1/4 POST  
WIT.-(1)HEMLOCK N15E 19  
(2)W. PINE S28W 88

1908 KNOX  
SEE PAGE 16

1978 PAUL LAPHAM-WORKSHEET  
SECTION SUBDIVISION

APPROVED LAND CORNER  
DEC 15 of 1996  
Gladwin County

Co. Rep. [Signature]  
Date 11/16/96

B. Description of corner evidence found and/or method applied in restoring or reestablishing corner:


FOUND 1/2" X 18" REROD 6" NORTH C/L OF COUNTY ROAD IN LINE WITH FENCES NORTH & SOUTH 14" BELOW SURFACE OF ROAD. SET GLADWIN RE-MON IN PLACE OF FOUND IRON.

SEE DOSSIER FOR DETAILED REPORT.

C. Description of monument for corner and accessories established to perpetuate locating the position of the corner:

B-9: 1/4 CORNER COMMON TO SECTIONS 19 & 30  
SET 5/8" X 36" REROD WITH GLADWIN RE-MON CAP MARKED P.S.#27458

WITNESSES:  
N80E 38" OAK, N&T, 98.85'  
S40E 4" MAPLE, N&T, 40.22'  
S10W 14" W. PINE, N&T, 28.39'  
N80W 12" B. WOOD, N&T, 83.48'

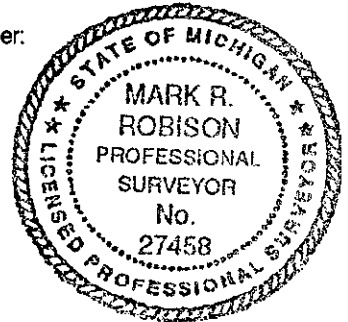

Signed by [Signature]  
Surveyor's Michigan License No. 27458

Date 11-29-96