

SURVEY & REMONUMENTATION

DEC 16 1996

COMMISSION

GLADWIN COUNTY REMONUMENTATION

LAND CORNER RECORDATION CERTIFICATE Filing Requirement of Act 74, Mich. P.A. 1970

LIBER **001** PAGE **138**

For corners in

GLADWIN	Located in:	Corner Code #	
(County)			
1. Public Land Survey	T <u>20N</u> R <u>1W</u>	<u>C - 8</u>	
	T ___ R ___	_____	
	T ___ R ___	_____	
	T ___ R ___	_____	
2. Property Controlling in Section	S ___ T ___ R ___	_____	
	S ___ T ___ R ___	_____	
3. Miscellaneous Property in Sec.	S ___ T ___ R ___	_____	
	S ___ T ___ R ___	_____	

STATE OF MICHIGAN
GLADWIN COUNTY
FILED-REMONUMENTATION

2 DEC 96 3:31 P.M.

BONNIE K. HOUSE
REGISTER OF DEEDS

Register of Deeds Stamp & File Number

4. Lot No. _____, Recorded Plat _____
5. Private Claims _____

I, MARK ROBISON, in a field survey on November, 1996 do hereby state that under requirements of P.A. 74, Michigan P.A. of 1970, the corner points mentioned in lines 1 and 2 above were in conformance with regulations and rules therefore as required in the current manual of survey instructions of the United States Department of the Interior, Bureau of Land Management or by a decree of a Court of Law and /or that the corner points mentioned in lines 3, 4 and 5 above were in conformance with the rules of the Michigan Board of Land Surveyors or by a Decree of a Court of Law; established, re-established, monumented, recovered, found as expressed below:

NOTE: Not more than 2 corners, all in the same town and range, may be recorded on this certificate.

	A	B	C	D	E	F	G	H	I	J	K	L	M
1													
2	6		5		4		3		2		1		
3													
4	7		8		9		10		11		12		
5													
6	18		17		16		15		14		13		
7													
8	19		20		21		22		23		24		
9													
10	30		29		28		27		26		25		
11													
12	31		32		33		34		35		36		
13													

A. Description of original monument and accessories and/or subsequent restoration:

1856 GEO E. ADAIR SET 1/4 POST WIT.-(1)HEMLOCK 17 N54E 10 (2)HEMLOCK 11 S50W 19	FENCE TO EAST WIT.-(4)4" TWIN APPLE N45W 61.20 (5)WHITE PINE STUB N45E 40 (IN FILE A-5)
1908 KNOX CEDAR 3" X 3" X 3' WIT.-(3)PINE 12" S83W 34	1978 PAUL LAPHAM L.C.R.C.#207 SET 1/2" IRON WIT.-(6)S45W 58.10 10" CEDAR (7)N25W 60.55 4" TWIN APPLE (8)N45E 39.80 24" WHITE PINE (STUB) (9)N80W 30.0 EAST POST
1969 PAUL LAPHAM SURVEY SET COR C/L ROAD OPP. DOWN	

MISC PAUL LAPHAM-SECTION SUBD.
WIT.-NONE

1980 PAUL LAPHAM-PLAT
NORTH WINCHESTER

B. Description of corner evidence found and/or method applied in restoring or reestablishing corner:

NO CORNER FOUND. SET CORNER FROM DATA AS RECORDED IN PLAT OF SALISBURY REALM, AS RECORDED IN LIBER 15 PAGES 19 - 23, AT 2630.28 FROM SW COR OF SECT 20. FOUND (6), 10" CEDAR WITH SPIKE IN SWAMP, LEANING; MEAS. 59+/-, REC. 58.10. SET GLADWIN RE-MON.

APPROVED LAND CORNER
PLAT OF 1996
Gladwin County


SEE DOSSIER FOR DETAILED REPORT.

Co. Rep. John Meyers
Date 11/6/96

C. Description of monument for corner and accessories established to perpetuate locating the position of the corner:

C-8: 1/4 CORNER COMMON TO SECTIONS 19 & 20
SET 5/8" X 36" REROD WITH GLADWIN RE-MON CAP MARKED P.S.#27458

WITNESSES:
S80E POWER POLE, N&T, 27.80'
N38E 10" OAK, N&T, 52.52'
N75W POWER POLE, N&T, 38.00'
N45W S'LY RIM MANHOLE 50.46'

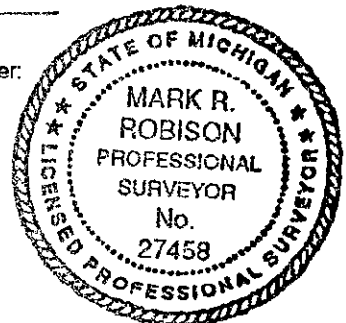

Signed by Mark R. Robison
Surveyor's Michigan License No. 27458

Date 11-29-96