

**SURVEY &
REMONUMENTATION**

DEC 16 1996

GLADWIN COUNTY REMONUMENTATION

COMMISSION

LAND CORNER RECORDATION CERTIFICATE
Filing Requirement of Act 74, Mich. P.A. 1970

LIBER **001** PAGE **139**

For corners in

GLADWIN

(County)

Located In:

Corner Code #

1. Public Land Survey

T 20N R 1W C - 9

T _____ R _____

T _____ R _____

T _____ R _____

2. Property Controlling
in Section

S _____ T _____ R _____

S _____ T _____ R _____

3. Miscellaneous
Property in Sec.

S _____ T _____ R _____

S _____ T _____ R _____

STATE OF MICHIGAN
GLADWIN COUNTY
FILED-REMONUMENTATION

2 DEC 96 3:31 P.M.

RONNIE K. HOUSE
REGISTER OF DEEDS

Register of Deeds Stamp & File Number

4. Lot No. _____, Recorded Plat _____

5. Private Claims _____

I, MARK ROBISON, in a field survey on November, 19 96 do hereby state that under requirements of P.A. 74, Michigan P.A. of 1970, the corner points mentioned in lines 1 and 2 above were in conformance with regulations and rules therefore as required in the current manual of survey instructions of the United States Department of the Interior, Bureau of Land Management or by a decree of a Court of Law and /or that the corner points mentioned in lines 3, 4 and 5 above were in conformance with the rules of the Michigan Board of Land Surveyors or by a Decree of a Court of Law; established, re-established, monumented, recovered, found as expressed below:

NOTE: Not more than 2 corners, all in the same town and range, may be recorded on this certificate.

1	A	B	C	D	E	F	G	H	I	J	K	L	M
2	6		5		4		3		2		1		
3													
4	7		8		9		10		11		12		
5													
6	18		17		16		15		14		13		
7													
8	19		20		21		22		23		24		
9													
10	30		29		28		27		26		25		
11													
12	31		32		33		34		35		36		
13													

A. Description of original monument and accessories and/or subsequent restoration:

1856 GEO E. ADAIR SET POST

WIT.-(1)ASPEN 5 N74 1/2W 18

(2)ASPEN 6 S50E 28

1908 KNOX FD STAKE MARKED WITH
GAS PIPE IN ROADBED

1989 PAUL LAPHAM FD 1" GAS PIPE

WIT.-(3)FENCE COR EAST 34.1

(4)30" W OAK N15W 69.20

(5)POWER POLE N30W 103.90

(IN FILE A-5)

1974 PAUL LAPHAM L.C.R.C.#94

FOUND 1" GAS PIPE

WIT.-(6)EAST 34.1 FENCE INTERSECTION

(7)N30W 103.9 P.P.

(8)N15W 69.2 30" W. OAK

1978 PAUL LAPHAM L.C.R.C.#207

FOUND 1 1/2" GAS PIPE

WIT.-(9)N30E 94.0 T.P.

(10)N80W 39.75 4" APPLE

(11)N30W 10.39 P.P.

(12)EAST 34.1 COR POST

MISC. PAUL LAPHAM

MISC. SECTION SUBD.

1978 PAUL LAPHAM-PLAT

HAMILTON REALM

1979 PAUL LAPHAM-PLAT

SOUTH WESTCHESTER REALM

B. Description of corner evidence found and/or method applied in restoring or reestablishing corner.

FOUND 1 1/2" GAS PIPE IN C/L OF NORTH-SOUTH ROAD, OPPOSITE FENCE TO EAST, 18" BELOW SURFACE GRAVEL CO. ROAD. FOUND (10), NO NAIL OR TAG, MEAS. 39+/- TO FACE. SET GLADWIN RE-MON IN GAS PIPE.

SEE DOSSIER FOR DETAILED REPORT.

APPROVED LAND CORNER

FILED 12/16/96

GLADWIN COUNTY

Co. Rep. Mark Robison

Date 11/6/96

C. Description of monument for corner and accessories established to perpetuate locating the position of the corner:

C-9: CORNER COMMON TO SECTIONS 19, 20, 29 & 30
SET 5/8" X 3/8" REROD WITH GLADWIN RE-MON CAP MARKED P.S.#27458


WITNESSES:

N45W POWER POLE, N&T, 105.20'

N80W 8" APPLE, N&T, 40.08'

EAST FENCE COR, N&T, 35.40'

N30E COR. POST, N&T, 93.00'

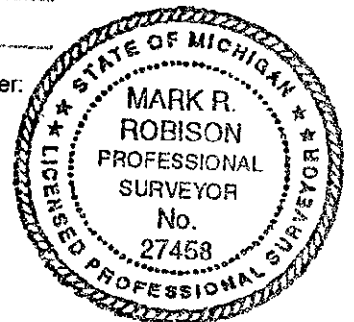

Signed by Mark R. Robison

Date 11-29-96

Surveyor's Michigan License No. 27458