

SURVEY & REMONUMENTATION

DEC 16 1996

COMMISSION

GLADWIN COUNTY REMONUMENTATION

LAND CORNER RECORDATION CERTIFICATE
Filing Requirement of Act 74, Mich. P.A. 1970

LIBER 001 PAGE 144

For corners in

GLADWIN (County)	Located in:	Corner Code #
1. Public Land Survey	T 20N R 1W	E - 5
	T R	
	T R	
	T R	
2. Property Controlling in Section	S T R	
	S T R	
3. Miscellaneous Property in Sec.	S T R	
	S T R	

STATE OF MICHIGAN
GLADWIN COUNTY
FILED-REMONUMENTATION
2 DEC 96 3:33 P.M.
BONNIE K. HOUSE
REGISTER OF DEEDS
Register of Deeds Stamp & File Number

4. Lot No. _____, Recorded Plat _____
5. Private Claims _____

I, MARK ROBISON, in a field survey on November, 19 96 do hereby state that under requirements of P.A. 74, Michigan P.A. of 1970, the corner points mentioned in lines 1 and 2 above were in conformance with regulations and rules therefore as required in the current manual of survey instructions of the United States Department of the Interior, Bureau of Land Management or by a decree of a Court of Law and /or that the corner points mentioned in lines 3, 4 and 5 above were in conformance with the rules of the Michigan Board of Land Surveyors or by a Decree of a Court of Law; established, re-established, monumented, recovered, found as expressed below:

A	B	C	D	E	F	G	H	I	J	K	L	M
1												
2	6	5	4	3	2	1						
3												
4	7	8	9	10	11	12						
5												
6	18	17	16	15	14	13						
7												
8	19	20	21	22	23	24						
9												
10	30	29	28	27	26	25						
11												
12	31	32	33	34	35	36						
13												

NOTE: Not more than 2 corners, all in the same town and range, may be recorded on this certificate.

A. Description of original monument and accessories and/or subsequent restoration:

- 1856 GEO E. ADAIR SET POST
WIT.-(1)W. BIRCH 6 N15E 28
(2)W. PINE 17 S34 1/2W 17
- 1975 PAUL LAPHAM-SECTION SUBD.
WIT.-NONE
- 1996 PAUL LAPHAM MEAS. TO F-5 2641.98
- 1989 PAUL LAPHAM-SECTION SUBD.
FOUND 1" SOLID BAR & STONE, OPP. FENCE NORTH & SOUTH
WIT.-(3)8" MAPLE N60W 64.80
(4)18" ELM N70E 91.60
(5)10" BIRCH N30W 41.05
- 1975 PAUL LAPHAM-PLAT HUNTINGTON REALM
- 1975 GRANGER SURVEY
NO COR. MATERIALS
WIT.-(6)P.P. N52W 126.65
(7)ST. SIGN S78W 119.97

APPROVED LAND CORNER
PLAT OF 11/10
GLADWIN COUNTY
Co. Rep. [Signature]
Date 11/16/96

B. Description of corner evidence found and/or method applied in restoring or reestablishing corner.


NO CORNER OR WITNESSES FOUND. SET CORNER FROM PLATTED DATA (PLAT OF HUNTINGTON REALM). FOUND MON. NW COR. LOT 74 & SW COR LOT 74; 1/2" IRON. SET GLADWIN RE-MON IN C/L ASPHALT ROAD. MEAS. 1996 TO F-5; AGREES WITH 1969 MEAS. BY PAUL LAPHAM.

SEE DOSSIER FOR DETAILED REPORT.

C. Description of monument for corner and accessories established to perpetuate locating the position of the corner:

E-5: CORNER COMMON TO SECTIONS 8, 9, 16 & 17
SET 5/8" X 3/8" REROD WITH GLADWIN RE-MON CAP MARKED P.S.#27458

- WITNESSES:
S60W CONC. MONUMENT 59.97'
N70W P.P., N&T, 118.35'
NOSE SOUTH COR. OF HOUSE (CONC) 127.52'
SOUTH 1/2" X 3/8" REROD 34.35'

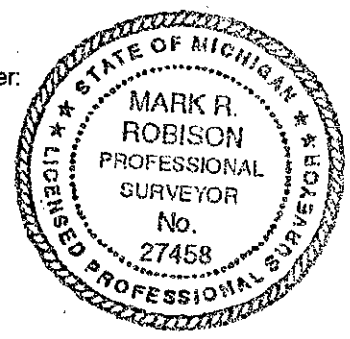

Signed by Mark R. Robison
Surveyor's Michigan License No. 27458

Date 11-29-96