

SURVEY & REMONUMENTATION

DEC 16 1996

COMMISSION

GLADWIN COUNTY REMONUMENTATION

LAND CORNER RECORDATION CERTIFICATE
Filing Requirement of Act 74, Mich. P.A. 1970

LIBER **001** PAGE **145**

For corners in

<u>GLADWIN</u> (County)	Located in:	Corner Code #
1. Public Land Survey	T <u>20N</u> R <u>1W</u>	<u>E - 9</u>
	T <u> </u> R <u> </u>	<u> </u>
	T <u> </u> R <u> </u>	<u> </u>
	T <u> </u> R <u> </u>	<u> </u>
2. Property Controlling in Section	S <u> </u> T <u> </u> R <u> </u>	<u> </u>
	S <u> </u> T <u> </u> R <u> </u>	<u> </u>
3. Miscellaneous Property in Sec.	S <u> </u> T <u> </u> R <u> </u>	<u> </u>
	S <u> </u> T <u> </u> R <u> </u>	<u> </u>
4. Lot No. _____, Recorded Plat _____		
5. Private Claims _____		

STATE OF MICHIGAN
GLADWIN COUNTY
FILED-REMONUMENTATION

2 DEC 96 3:33 P.M.

BONNIE K. HOUSE
REGISTER OF DEEDS

Register of Deeds Stamp & File Number

I, MARK ROBISON, in a field survey on November, 19 96 do hereby state that under requirements of P.A. 74, Michigan P.A. of 1970, the corner points mentioned in lines 1 and 2 above were in conformance with regulations and rules therefore as required in the current manual of survey instructions of the United States Department of the Interior, Bureau of Land Management or by a decree of a Court of Law and /or that the corner points mentioned in lines 3, 4 and 5 above were in conformance with the rules of the Michigan Board of Land Surveyors or by a Decree of a Court of Law; established, re-established, monumented, recovered, found as expressed below:

NOTE: Not more than 2 corners, all in the same town and range, may be recorded on this certificate.

A	B	C	D	E	F	G	H	I	J	K	L	M
1												
2	6		5		4		3		2		1	
3												
4	7		8		9		10		11		12	
5												
6	18		17		16		15		14		13	
7												
8	19		20		21		22		23		24	
9												
10	30		29		28		27		26		25	
11												
12	31		32		33		34		35		36	
13												

A. Description of original monument and accessories and/or subsequent restoration:

1856 GEO E. ADAIR
SET POST
WIT.-(1)B. ASH 10 S84 1/2W 29
(2)B. ASH 13 N85 1/2E 28

FOUND ROD
WIT.-(5)N45E 34.2 STREET SIGN
(6)N15E 28.4 WEST LEG SIGN
(7)N45W 46.2 PLAT IRON
(8)S45E 46.9 COR. POST

1969 PAUL LAPHAM-SECTION SUBD.
FOUND WOOD STAKE & TRUSS ROD
WIT.-(3)FENCE COR. S45E 46.90
(4)10" TWIN ELM N80E 73.80

1980+- PAUL LAPHAM-PLAT
SALISBURY REALM
BERKSHIRE REALM

1978 PAUL LAPHAM L.C.R.C.#207

B. Description of corner evidence found and/or method applied in restoring or reestablishing corner:

APPROVED LAND CORNER

P.A. 273 of 1996
Gladwin County

Co. Rep. [Signature]
Date 11/6/96


NO CORNER FOUND. SET CORNER IN C/L OF COUNTY ROAD DITCH FROM PLATTED LOCATION FROM PLAT OF SALISBURY REALM, LIBER 15, PAGES 12 - 16. FOUND (6); MEAS. 26.5, REC. 26.4. SET GLADWIN RE-MON FROM ABOVE INFO IN COUNTY ROAD DITCH 27+- NW'ly OF C/L ON EXTENDED CENTER LINES S & E.

SEE DOSSIER FOR DETAILED REPORT.

C. Description of monument for corner and accessories established to perpetuate locating the position of the corner:

E-9: CORNER COMMON TO SECTIONS 20, 21, 28 & 29
SET 5/8" X 3/8" REROD WITH GLADWIN RE-MON CAP MARKED P.S.#27458

WITNESSES:
NORTH 10' X 2 1/2" STEEL POST 16.20'
S45E 1/2" X 3/8" REROD 58.0'
S70W 8" POPLAR, N&T, 49.05'
N30W MANHOLE SE'LY RIM

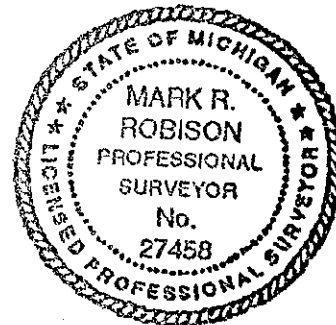

Signed by Mark R. Robison
Surveyor's Michigan License No. 27458

Date 11-29-96