

DEC 16 1996

GLADWIN COUNTY REMONUMENTATION

COMMISSIONER

LAND CORNER RECORDATION CERTIFICATE
Filing Requirement of Act 74, Mich. P.A. 1970

LIBER 001 PAGE 154

For corners in

GLADWIN (County)	Located In:	Corner Code #
1. Public Land Survey	T 20N R 1W	G - 8
	T R	
	T R	
	T R	
2. Property Controlling in Section	S T R	
	S T R	
3. Miscellaneous Property in Sec.	S T R	
	S T R	

STATE OF MICHIGAN
GLADWIN COUNTY
FILED-REMONUMENTATION

2 DEC 96 3:35 P.M.

BONNIE K. HOUSE
REGISTER OF DEEDS

Register of Deeds Stamp & File Number

4. Lot No. _____, Recorded Plat _____
5. Private Claims _____

I, MARK ROBISON, in a field survey on November, 19 96, do hereby state that under requirements of P.A. 74, Michigan P.A. of 1970, the corner points mentioned in lines 1 and 2 above were in conformance with regulations and rules therefore as required in the current manual of survey instructions of the United States Department of the Interior, Bureau of Land Management or by a decree of a Court of Law and /or that the corner points mentioned in lines 3, 4 and 5 above were in conformance with the rules of the Michigan Board of Land Surveyors or by a Decree of a Court of Law; established, re-established, monumented, recovered, found as expressed below:

NOTE: Not more than 2 corners, all in the same town and range, may be recorded on this certificate.

	A	B	C	D	E	F	G	H	I	J	K	L	M
1													
2		6		5		4		3		2		1	
3													
4		7		8		9		10		11		12	
5													
6		18		17		16		15		14		13	
7													
8		19		20		21		22		23		24	
9													
10		30		29		28		27		26		25	
11													
12		31		32		33		34		35		36	
13													

A. Description of original monument and accessories and/or subsequent restoration:

1856 GEO E. ADAIR SET 1/4 POST WIT.-(1)MAPLE 10 N38W 32 (2)CEDAR 13 S38E 21	1973 PAUL LAPHAM SURVEY & WORKING DRAWING
1989 PAUL LAPHAM-SECTION SUBD. SET R/R SPIKE WIT.-(3)4" BASSWOOD N70E 31.05 (4)HOLE CENTER LARGE STONE S70E 23.90 (5)2" CEDAR N45W 50.80	1980+/- EDMAND ENG.-WORKING DWG
	1987 EDMAND ENG.-ROAD PLANS WIT.-(6)S83W 105' FACE U.P. (7)NE 38.1 TO ST'L FE. POST (8)SE 39.3 TO ST'L FE POST (9)EAST 30.5 TO N-S FENCE

1994 PAUL LAPHAM SURVEY
FOUND P.K. NAIL
WIT.-(10)S85W 105.20 P.P.
(11)N70W 102.20 6" RED PINE
(12)N45E 78.50 8" ELM
(13)S70E 64.15 8" POPLAR

B. Description of corner evidence found and/or method applied in restoring or reestablishing corner:

FOUND P.K. NAIL SET BY PAUL LAPHAM IN 1990, FROM 1969 FIELD DATA, IN C/L OF ASPHALT ROAD; AGREES WITH FOUND WITNESSES (6) THRU (13), AND 1996 MEASUREMENTS TO G-9 AND G-7, 2652.72 & 2644.06. SET GLADWIN RE-MON FROM FOUND WITNESSES & P.K. NAIL

SEE DOSSIER FOR DETAILED REPORT.


APPROVED LAND CORNER
P.A. 74, 1970
Gladwin County

Co. Rep. Mark R. Robison
Date 11/6/96

C. Description of monument for corner and accessories established to perpetuate locating the position of the corner:

G-8: 1/4 CORNER COMMON TO SECTIONS 21 & 22
SET 5/8" X 3/8" REROD WITH GLADWIN RE-MON CAP MARKED P.S.#27458 IN MONUMENT BOX.

WITNESSES:
S85W 105.20' P.P. S70E 64.15' 8" POPLAR
N70W 102.20' 6" RED PINE NORTH, P.K. NAIL, 2.0'
N45E 78.50' 8" ELM EAST, P.K. NAIL, 2.0'

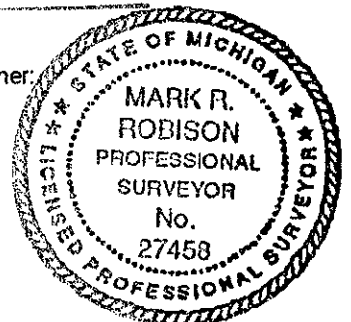

Signed by Mark R. Robison
Surveyor's Michigan License No. 27458

Date 11-29-96