

DEC 1 8 1996

COMMISSION

LAND CORNER RECORDATION CERTIFICATE
Filing Requirement of Act 74, Mich. P.A. 1970

LIBER 001 PAGE 102

For corners in

GLADWIN

(County)

Located In:

Corner Code #

- 1. Public Land Survey T20N R1W M - 1
T R
T R
T R
- 2. Property Controlling S T R
in Section S T R
- 3. Miscellaneous S T R
Property in Sec. S T R

STATE OF MICHIGAN
GLADWIN COUNTY
FILED - CORNER

2 DEC 96 3:22 P.M.

BONNIE K. HOUSE
REGISTER OF DEEDS

Register of Deeds Stamp & File Number

- 4. Lot No. _____, Recorded Plat _____
- 5. Private Claims _____

I, MARK ROBISON, in a field survey on NOVEMBER, 1996 do hereby state that under requirements of P.A. 74, Michigan P.A. of 1970, the corner points mentioned in lines 1 and 2 above were in conformance with regulations and rules therefore as required in the current manual of survey instructions of the United States Department of the Interior, Bureau of Land Management or by a decree of a Court of Law and /or that the corner points mentioned in lines 3, 4 and 5 above were in conformance with the rules of the Michigan Board of Land Surveyors or by a Decree of a Court of Law; established, re-established, monumented, recovered, found as expressed below:

NOTE: Not more than 2 corners, all in the same town and range, may be recorded on this certificate.

1	A	B	C	D	E	F	G	H	I	J	K	L	M
2		6		5		4		3		2		1	
3													
4		7		8		9		10		11		12	
5													
6		18		17		16		15		14		13	
7													
8		19		20		21		22		23		24	
9													
10		30		29		28		27		26		25	
11													
12		31		32		33		34		35		36	
13													

- A. Description of original monument and accessories and/or subsequent restoration:
- 1836 JOHN MULLETT (4)BLAZE 8" CEDAR WIT.--(5)SP. IN 10" CEDAR ESE 12.65
 - WIT.--(1)PINE 30 N33W 20 S16W 13.2 (6)SP. IN 10" CEDAR SSW 13.20
 - (2)MAPLE 12 N43E 51 (7)SP. IN 24" N PINE WSW 27.55
 - 1950 OSTLING SURVEY 1970 PAUL LAPHAM SECTION SUBDIVISION 1992 PAUL LAPHAM SURVEY
 - FOUND ORIGINAL POST WIT.--SAME AS (5),(6)&(7)
 - PLACED 4" X 48" SQD. POST 1991 ARLETH SURVEY
 - WIT.--(3)BLAZE 20" N PINE FOUND OLD POST 1992 PAUL LAPHAM SURVEY
 - S80W 26.9 SET 3/4" X 44" PIPE WIT.--SAME AS (5),(6)&(7)

B. Description of corner evidence found and/or method applied in restoring or reestablishing corner:

FOUND 3/4" PIPE & SQUARE WOOD POST AT BASE OF 10" FENCE CORNER POST. FOUND WITNESSES (3)&(7). SET GLADWIN RE-MON FROM FOUND CORNER & WITNESSES (3)&(7).

APPROVED LAND CORNER

P.A. 345 of 1990

Gladwin County


SEE DOSSIER FOR DETAILED REPORT.

Co. Rep. John M. Rogers
Date 11/4/96

C. Description of monument for corner and accessories established to perpetuate locating the position of the corner:

M-1: NE CORNER OF SECTION 1

- WITNESSES:
- S15E 24" W. PINE, N&T, 40.70'
 - N80E 24" W. OAK, N&T, 33.80'
 - S45W 18" OAK, N&T, 43.30'
 - S85W 20" PINE STUMP (F.J.A. CAP) 27.55'

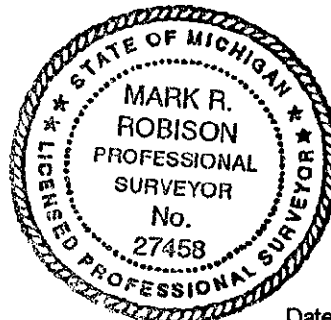

Signed by Mark R. Robison
Surveyor's Michigan License No. 27458

Date 12-02-96