


FEB 18 1994

LAND CORNER RECORDATION CERTIFICATE  
Filing Requirement of Act 74, Mich. P.A. 1970

DEC 29 '93 AM

For corners in COMMISSION

GLADWIN (County)	Located In:	Corner Code #
1. Public Land Survey	T <u>20N</u> R <u>1W</u>	<u>M-9</u>
	T _____ R _____	_____
	T _____ R _____	_____
	T _____ R _____	_____
2. Property Controlling in Section	S _____ T _____ R _____	_____
	S _____ T _____ R _____	_____
3. Miscellaneous Property in Sec.	S _____ T _____ R _____	_____
	S _____ T _____ R _____	_____

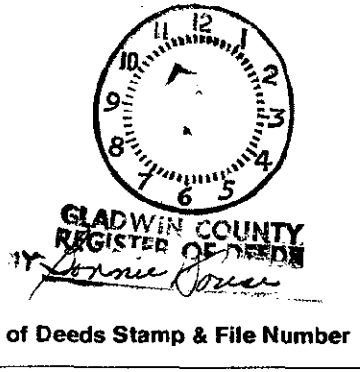

- 4. Lot No. \_\_\_\_\_, Recorded Plat \_\_\_\_\_
- 5. Private Claims \_\_\_\_\_

I, PAUL B. LAPHAM, in a field survey on OCTOBER, 19 93, do hereby certify that under requirements of P.A. 74, Michigan P.A. of 1970, the corner points mentioned in lines 1 and 2 above were in conformance with regulations and rules therefore as required in the current manual of survey instructions of the United States Department of the Interior, Bureau of Land Management or by a decree of a Court of Law and/or that the corner points mentioned in lines 3, 4 and 5 above were in conformance with the rules of the Michigan Board of Land Surveyors or by a Decree of a Court of Law; established, re-established, monumented, re-monumented, recovered, found as expressed below:

**NOTE: Not more than 4 corners, all in the same town and range, may be recorded on this certificate.**

	A	B	C	D	E	F	G	H	I	J	K	L	M
2	6	5	4	3	2	1							
3													
4	7	8	9	10	11	12							
5													
6	18	17	16	15	14	13							
7													
8	19	20	21	22	23	24							
9													
10	30	29	28	27	26	25							
11													
12	31	32	33	34	35	36							
13													

A. Description of original monument and accessories and/or subsequent restoration:

- 1837 BRINK, BIRCH 15" DIA., CORNER SECTIONS 24 & 25 P.649
- 1839 NICHOLSON, W. PINE 28" N 65°W, 39 LKS P. 665
- HEMLOCK 6" S 02-1/2°W, 13 LKS
- 03-07-61 H. GILBERT, 3/4" ROD IN MON. BOX, 2.69' LEFT OF C
- N 45°W, 50.20' - TWIN 7" PINE
- S 45°W, 58.74' - 8" PINE
- N 60°E, 47.85' - 6" POPLAR

B. Description of corner evidence found and/or method applied in restoring or reestablishing corner:

- FOUND 3/4" x 36" IRON BAR IN MONUMENT BOX. EXCAVATED TO 1-1/2' DEPTH, FOUND CONCRETE.
- FOUND NO OTHER EVIDENCE. REMOVED IRON BAR.
- FOUND RECORDED WITNESSES:
- N 45°W, 50.20' - TWIN 7" PINE
- S 45°W, 58.74' - 8" PINE

This Corner established in Gladwin County Remonumentation Program.  
See dossier for detailed report.

C. Description of monument for corner and accessories established to perpetuate locating the position of the corner:

- SET 5/8" X 36" RE-ROD WITH 2" GLADWIN COUNTY MONUMENT CAP IN MONUMENT BOX.
- N 45°W, 50.60' - PINE STUMP
- S 45°W, 58.60' - PINE (10")
- S 50°E, 65.35' - 6" FIR
- N 80°E, 53.14' - 10" PINE



Signed by Paul B. Lapham Date 12/08/93  
 Surveyor's Michigan License No. 9433