GLADWIN COUNTY REMONUMENTATION PROGRAM

PAGE 15

5. Private Claims

FEB 1 8 1994

LAND CORNER RECORDATION CERTIFICATE Filing Requirement of Act 74, Mich. P.A. 1970

THEE 29 193 AM

10

11

For corners in				13
	GLADWIN (County)	Located In:	Corner Code ##	10 com
1.	Public Land Survey	T <u>20N</u> R <u>1W</u> T R T R	<u>M-11</u>	GLADWIN COUNTY
2.	Property Controlling in Section	S T R S T R		REGISTER OF DEADS
3.	Miscellaneous Property in Sec.	S T R S T R		Register of Deeds Stamp & File Number
4	Lot No	Recorded Plat		

PAUL B. LAPHAM , in a field survey on OCTOBER 19 **93** do hereby certify that under requirements of P.A. 74, Michigan P.A. of 1970, the corner points mentioned in lines 1 and 2 above were in conformance with regulations and rules therefore as required in the current manual of survey instructions of the United States Department of the Interior, Bureau of Land Management or by a degree of a Court of Law and/or that the corner points mentioned in lines 3, 4 and 5 above were in conformance with the rules of the Michigan Board of Land Surveyors or by a Decree of a Court of Law; established, re-established, monumented, re-monumented, recovered, found as expressed below:

NOTE: Not more than 4 corners, all in the same town and range, may be recorded on this certificate.

Description of original monument and accessories and/or subsequent restoration 1837 BRINK, POST, WHITE PINE 12" S 3/4°E 482 P.648
1949 HIGGINS, 1" PIPE, M.S.H.D. PLANS

N 52°W, 47.40' ~ F. POST

N 74°E, 80.54' ~ S.W. COR. GAS STA.

S 56°E, 49.09' ~ 5" N. PINE

S 70°W, 81.45' ~ 20" W. PINE

O3-07-61 H. GILBERT, 3/4" ROD IN MON. BOX, M.S.H.D. WITNESS CARD

N 55°W, 32.81' ~ CH.SQ. N.E. COR. HDWL.

S 55°W, 31.84' ~ CH.SQ. S.E. COR. HDWL.

N 82°E, 80.91' ~ 6" BLUE SPRUCE A. Description of original monument and accessories and/or subsequent restoration:

07-20-75, MONUMENT BOX, LCRC # 120

B. Description of corner evidence found and/or method applied in restoring or reestablishing corner:

x 14" IRON PIPE IN MONUMENT BOX. EXCAVATED TO 3 FOOT DEPTH, FOUND NO OTHER EVIDENCE. FOUND RECORDED WITNESSES: S 70°W, 81.45' - 20" W. PINE S 80°E, 54.70' - POWER POLE N 50°W, 65.2' - POWER POLE


This Corner established in Gladwin County Remonumentation Program. See dossier for detailed report.

SET 5/8" X 36" RE-ROD WITH 2" GLADWIN COUNTY MONUMENT CAP IN MONUMENT BOX.

N 45°W, 96.05' - 18" WHITE PINE

N 85°E, 74.95' - S.W. CORNER, BLDG.

S 70°W, 81.74' -- 24" PINE
S 75°E, 54.95' - POWER POLE

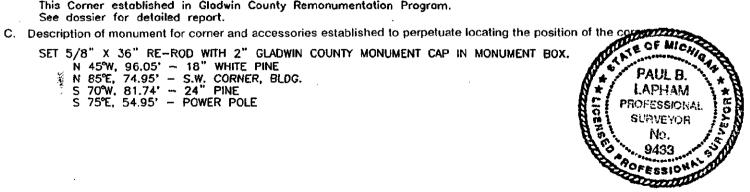

Signed by Laul A. Lyhan	Date	12-8-93
0-1/2-		

Surveyor's Michigan License No. _