SURVEY & REMONUMENTATION

FEB 18 1994

COMMISSION

PAGE 16

DEC 29 93 AM

LAND CORNER RECORDATION CERTIFICATE

Filing Requirement of Act 74, Mich. P.A. 1970

For corners in GLADWIN (County)

	Located In:	Corner Code #
1. Public Land Survey	T 20N R 1W	M-13
	T ___ R ___	
	T ___ R ___	
	T ___ R ___	
2. Property Controlling	S ___ T ___ R ___	
in Section	S ___ T ___ R ___	
3. Miscellaneous	S ___ T ___ R ___	
Property in Sec.	S ___ T ___ R ___	

GLADWIN COUNTY REGISTER OF DEEDS

Register of Deeds Stamp & File Number

4. Lot No. _____ , Recorded Plat _____
5. Private Claims _____

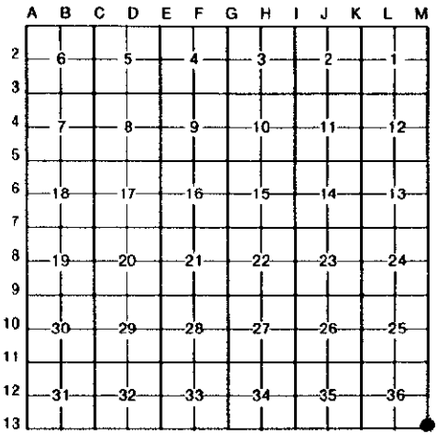

I, MARK R. ROBISON, in a field survey on OCTOBER, 19 93, do hereby certify that under requirements of P.A. 74, Michigan P.A. of 1970, the corner points mentioned in lines 1 and 2 above were in conformance with regulations and rules therefore as required in the current manual of survey instructions of the United States Department of the Interior, Bureau of Land Management or by a decree of a Court of Law and/or that the corner points mentioned in lines 3, 4 and 5 above were in conformance with the rules of the Michigan Board of Land Surveyors or by a Decree of a Court of Law; established, re-established, monumented, re-monumented, recovered, found as expressed below:

NOTE: Not more than 4 corners, all in the same town and range, may be recorded on this certificate.

A. Description of original monument and accessories and/or subsequent restoration:

1833 NICHOLSON, SET POST, CORNER T19 & 20N, R1W, P. 99
1877 T. MERRILL, POST COR. TWP. 19 & 20N, R1W P.648
BIRCH 11" S 42°W, 40 LKS
ASPEN 16" N 40-1/2°W 15 LKS
11-30-62 GILBERT, 1" PIPE IN MON. BOX, M.S.H.D. WITNESS CARD
N 24°W, 80.08' - 8" POPLAR
N 50°W, 66.69' - 6" POPLAR
S 76°W, 45.90' - 8" POPLAR
07-30-75 LAPHAM, LCRC #120

B. Description of corner evidence found and/or method applied in restoring or reestablishing corner:

FOUND 5/8" ROD IN MSHD MON. BOX. EXCAVATED TO 3' DEPTH - FOUND NO OTHER EVIDENCE.
FOUND NO RECORDED WITNESSES.

This Corner established in Gladwin County Remonumentation Program.
See dossier for detailed report.

C. Description of monument for corner and accessories established to perpetuate locating the position of the corner:

SET 5/8" X 36" RE-ROD WITH 2" GLADWIN COUNTY MONUMENT CAP IN MONUMENT BOX.
S 20°E, 95.00' - POWER POLE
S 35°W, 61.29' - 8" WHITE PINE
N 35°W, 63.70' - 12" POPLAR
N 75°E, 54.72' - 8" ASH

STATE OF MICHIGAN
MARK R. ROBISON
PROFESSIONAL SURVEYOR
No. 27458
LICENSED PROFESSIONAL SURVEYOR

Signed by Mark R Robison Date 2-11-94

Surveyor's Michigan License No. 27458

FORM APPROVED BY MICHIGAN STATE BOARD OF LAND SURVEYORS, JAN. 28, 1971
REVISED MAY 14, 1975
REVISED JAN., 1983