

LAND CORNER RECORDATION CERTIFICATE
 Filing Requirement of Act 74, Mich. P.A. 1970

Register's Office }
 Gogebic County } ss.

For corners in
Gogebic
 (County)

1. Public Land Survey

Located In: Corner Code #/ #
 44/ B-1
 T 43N R 38W
 T R
 T R
 T R

2. Property Controlling in Section

S T R
 S T R

3. Miscellaneous Property in Sec.

S T R
 S T R

4. Lot No. _____, Recorded Plat

5. Private Claims

PEER GROUP
APPROVED
Richard L. Dralun 1/20/94

Received for record the
3RD day of FEBRUARY
 A. D. 1993 at 10:35 o'clock
A m., and recorded in
 Liber 4 of CORNERS
 on page 219
Richard J. Brown
 Register of Deeds

Register of Deeds Stamp & File Number

I, Gary L. Pisoni, in a field survey on November 12, 19 92, do hereby certify that under requirements of P.A. 74, Michigan P.A. of 1970, the corner points mentioned in lines 1 and 2 above were in conformance with regulations and rules therefore as required in the current manual of survey instructions of the United States Department of the Interior, Bureau of Land Management or by a decree of a Court of Law and/or that the corner points mentioned in lines 3, 4 and 5 above were in conformance with the rules of the Michigan Board of Land Surveyors or by a Decree of a Court of Law; established, re-established, monumented, re-monumented, recovered, found as expressed below:

	A	B	C	D	E	F	G	H	I	J	K	L	M
2	6	5	4	3	2								
3													
4	7	8	9	10	11	12							
5													
6	18	17	16	15	14	13							
7													
8	19	20	21	22	23	24							
9													
10	30	29	28	27	26	25							
11													
12	31	32	33	34	35	36							
13													

NOTE: Not more than 4 corners, all in the same town and range, may be recorded on this certificate.

A. Description of original monument and accessories and/or subsequent restoration:
 Original corner established by Austin Burt, U.S. Deputy Surveyor on June 8, 1847.
 Original corner: Cedar Post
 Original bearing trees:

Tamarack	12"	N 43°E	26 links (17.16 feet)
Tamarack	12"	N 50°W	22 links (14.52 feet)


B. Description of corner evidence found and/or method applied in restoring or reestablishing corner:
 No original corner evidence found. Corner restored by single proportionate measurement methods on line between the Northeast and Northwest Section corners of Section 6.

C. Description of monument for corner and accessories established to perpetuate locating the position of the corner:
 At the corner position I set a 3/4" outside diameter by 8 feet long aluminum rod monument with a 3" cast aluminum cap, stamped to read; T44N, R 38W; 1/4; S-31; S-6; T43N; 1992; R.L.S. 27457 from which I established the following new blazed and scribed bearing trees: (all measurements taken to a nail in side of tree)

Cedar	3"	N 22°W	16.89 feet
Cedar	9"	N 87°E	80.86 feet
Steel Sign Post		North	0.90 feet
Steel Sign Post		West	1.20 feet

Signed by Gary L. Pisoni
 Surveyor's Michigan License No. 27457

Date 1/28/93

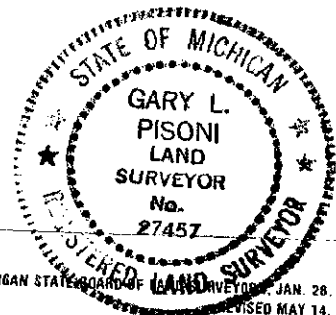

FORM APPROVED BY MICHIGAN STATE BOARD OF LAND SURVEYORS, JAN. 28, 1971
 REVISED MAY 14, 1975
 REVISED JAN., 1983