

SURVEY &  
REMONUMENTATION


JAN 20 1999

LAND CORNER MONUMENTS

T. 43 N., R. 39 W.

SECTION

WATERSMEET TOWNSHIP

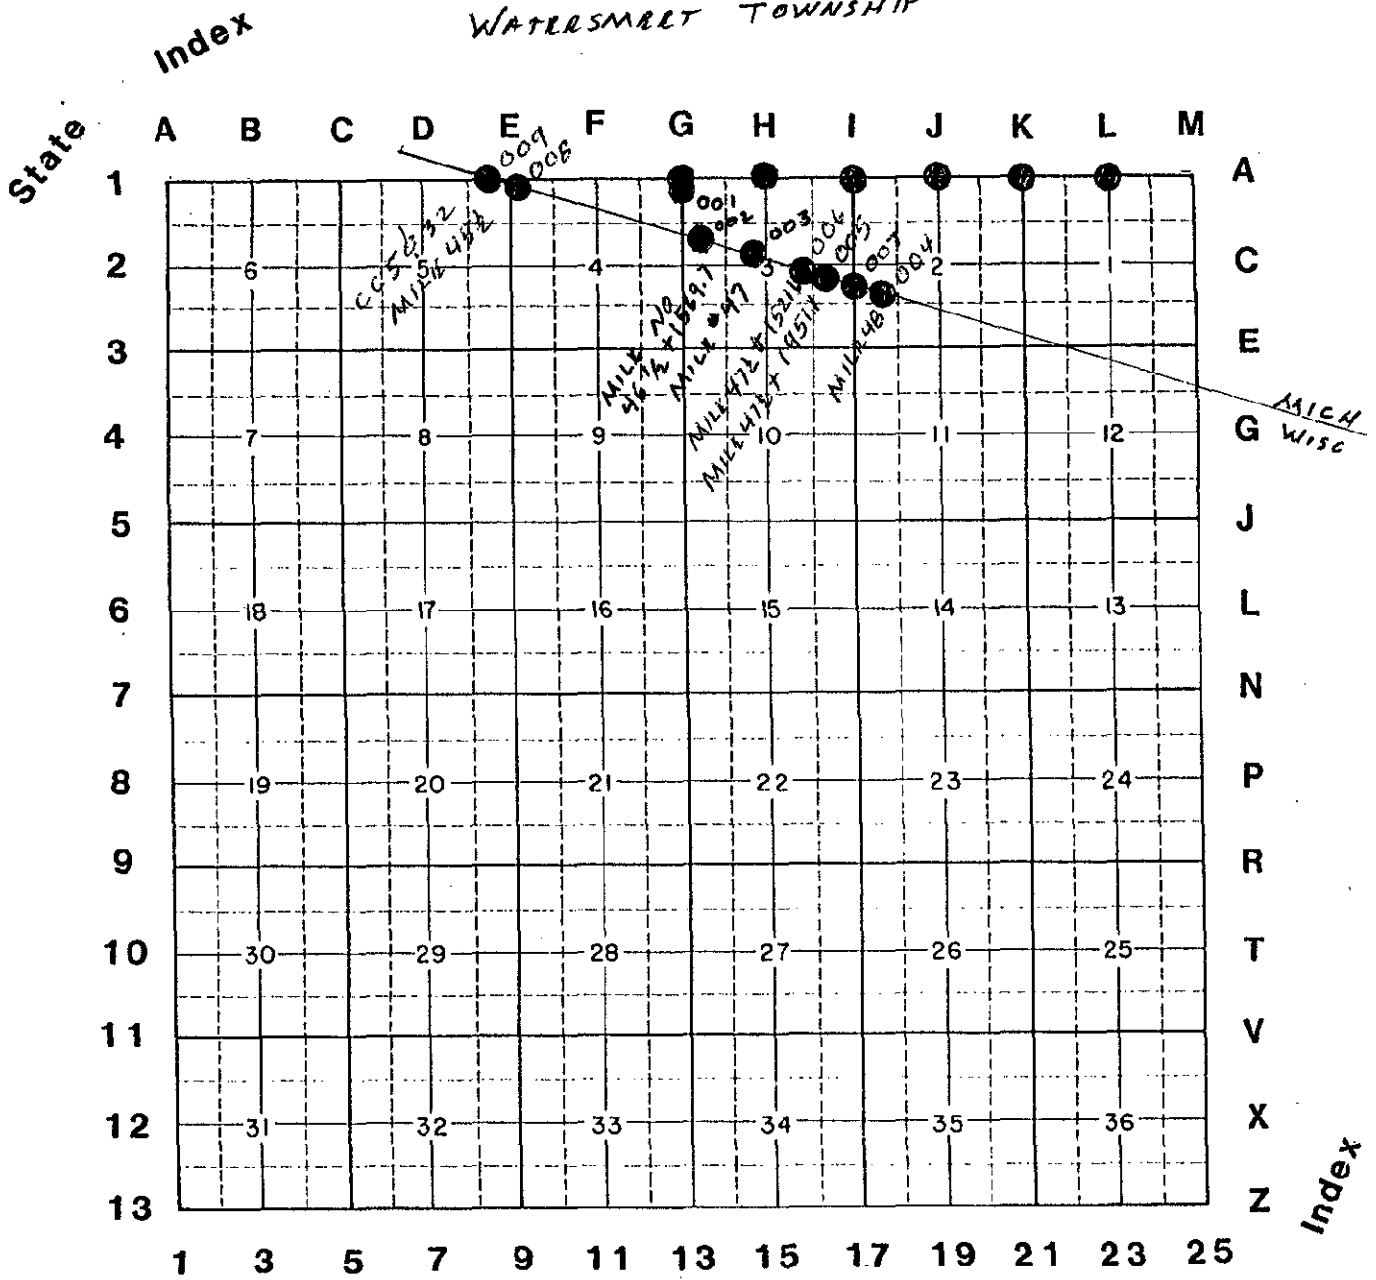

AS OF 12/31/98

LEGEND

Federal Index

- GLO Corners researched
- ⊙ GLO Corners monumented, not approved
- ⊗ GLO Corners approved
- GLO Corners approved & reported to State

T. 43 N., R. 39 W.