

LAND CORNER RECORDATION CERTIFICATE
Filing Requirement of Act 74, Mich. P.A. 1970

Register's Office }
 Gogebic County } ss.

For corners in

Gogebic
 (County)

Located In: Corner Code #/

44/ 38 E-13

1. Public Land Survey	T	<u>43N</u>	R	<u>38W</u>	E-1
	T	_____	R	_____	_____
	T	_____	R	_____	_____
	T	_____	R	_____	_____
2. Property Controlling in Section	S	_____	T	_____	R
	S	_____	T	_____	R
3. Miscellaneous Property in Sec.	S	_____	T	_____	R
	S	_____	T	_____	R

Received for record the
3rd day of FEBRUARY
 A. D. 1993 at 10:35 o'clock
A m., and recorded in
 Liber 4 of CORNERS
 on page 221
Richard J. Brown
 Register of Deeds

Register of Deeds Stamp & File Number

4. Lot No. _____, Recorded Plat _____
 5. Private Claims _____

I, Gary L. Pisoni, in a field survey on November 3, 1992, do hereby certify that under requirements of P.A. 74, Michigan P.A. of 1970, the corner points mentioned in lines 1 and 2 above were in conformance with regulations and rules therefore as required in the current manual of survey instructions of the United States Department of the Interior, Bureau of Land Management or by a decree of a Court of Law and/or that the corner points mentioned in lines 3, 4 and 5 above were in conformance with the rules of the Michigan Board of Land Surveyors or by a Decree of a Court of Law; established, re-established, monumented, re-monumented, recovered, found as expressed below:

A	B	C	D	E	F	G	H	I	J	K	L	M
2	6	5	4	3	2	1						
3												
4	7	8	9	10	11	12						
5												
6	18	17	16	15	14	13						
7												
8	19	20	21	22	23	24						
9												
10	30	29	28	27	26	25						
11												
12	31	32	33	34	35	36						
13												

NOTE: Not more than 4 corners, all in the same town and range, may be recorded on this certificate.

A. Description of original monument and accessories and/or subsequent restoration:

Original corner established by Austin Burt, U.S. Deputy Surveyor on June 8, 1847.
 Original corner: Sugar Post
 Original bearing trees:

Sugar	10"	S 78°W	44 links (29.04 feet)
Lynn	10"	S 52°E	26 links (17.16 feet)
Fir	8"	N 42°E	40 links (26.4 feet)
Fir	7"	N 57°W	43 links (28.38 feet)

B. Description of corner evidence found and/or method applied in restoring or reestablishing corner:


No original corner evidence found. Corner restored by single proportionate measurement methods on line between the Northwest corner of Section 5 and the Northeast corner of Section 3.

PEER GROUP APPROVED
Richard L. Wrahn 1/20/94
COUNTY REPRESENTATIVE

C. Description of monument for corner and accessories established to perpetuate locating the position of the corner:

At the corner position, I set a 2" diameter by 30" long split base aluminum pipe monument with a 3" cast aluminum cap, stamped to read: T44N, R38W; S-32, S-33, S-5, S-4, T43N, 1992, RLS 27457 from which I established the following new blazed and scribed bearing trees: (all measurements taken to a nail in side of tree)

Sugar Maple	7"	N 26°W	25.70 feet
Sugar Maple	14"	N 75°E	16.36 feet
Sugar Maple	12"	S 06°E	26.83 feet
Steel sign post		West	0.75 feet

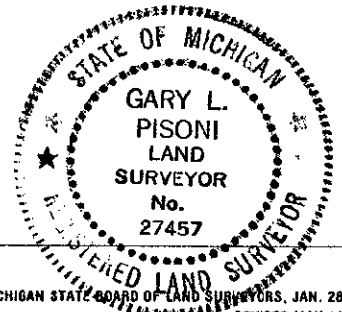

Signed by Gary L. Pisoni

Date 1/28/93

Surveyor's Michigan License No. 27457