

Register's Office }
Gogebic County } ss.

LAND CORNER RECORDATION CERTIFICATE
Filing Requirement of Act 74, Mich. P.A. 1970

For corners in
Gogebic
(County)

Received for record the
3RD day of FEBRUARY
A. D. 1993 at 10:35 o'clock
A m., and recorded in
Liber 4 of CORNERS
on page 225.
Richard L. Brown, Jr.
Register of Deeds

	Located In:	Corner Code #:
	<u>44/ 38</u>	<u>I-13</u>
1. Public Land Survey	T <u>43N</u> R <u>38W</u>	<u>I-1</u>
	T _____ R _____	_____
	T _____ R _____	_____
	T _____ R _____	_____
2. Property Controlling in Section	S _____ T _____ R _____	_____
	S _____ T _____ R _____	_____
3. Miscellaneous Property in Sec.	S _____ T _____ R _____	_____
	S _____ T _____ R _____	_____
4. Lot No. _____, Recorded Plat _____		
5. Private Claims _____		

Register of Deeds Stamp & File Number

I, Gary L. Pisoni, in a field survey on November 3, 19 92, do hereby certify that under requirements of P.A. 74, Michigan P.A. of 1970, the corner points mentioned in lines 1 and 2 above were in conformance with regulations and rules therefore as required in the current manual of survey instructions of the United States Department of the Interior, Bureau of Land Management or by a decree of a Court of Law and/or that the corner points mentioned in lines 3, 4 and 5 above were in conformance with the rules of the Michigan Board of Land Surveyors or by a Decree of a Court of Law; established, re-established, monumented, re-monumented, recovered, found as expressed below:

	A	B	C	D	E	F	G	H	I	J	K	L	M
2	6	5	4	3	2	1							
3													
4	7	8	9	10	11	12							
5													
6	18	17	16	15	14	13							
7													
8	19	20	21	22	23	24							
9													
10	30	29	28	27	26	25							
11													
12	31	32	33	34	35	36							
13													

NOTE: Not more than 4 corners, all in the same town and range, may be recorded on this certificate.

A. Description of original monument and accessories and/or subsequent restoration:

Original corner established by Austin Burt, U.S. Deputy Surveyor on June 8, 1847.
Original corner: Wood Post
Original bearing trees:

Yellow Birch	14"	S 72° E	36 links (23.76 feet)
Hemlock	8"	S 43° W	13 links (8.58 feet)
Sugar	14"	N 38° E	41 links (27.06 feet)
Sugar	7"	N 02° W	34 links (22.44 feet)

B. Description of corner evidence found and/or method applied in restoring or reestablishing corner:


Found old partially decayed wood post lying on ground at corner position.
Restored corner position at record bearing and distance from the decayed remains of a 16"-18" Hemlock stump and a shallow Yellow Birch stump hole.
No evidence found of Sugar bearing trees.
Found old rusty U.S. Forest Service tag lying on ground near wood post.
Accepted wood post and bearing trees as best available evidence for restoring corner position.

PEER GROUP APPROVED
Richard L. Dealin 1/20/94
COUNTY REPRESENTATIVE

C. Description of monument for corner and accessories established to perpetuate locating the position of the corner:

At the corner position, I set a 2" diameter by 30" long split base aluminum pipe monument with a 3" cast aluminum cap, stamped to read; T44N, R38W; S-34; S-35; S-3; S-2; T43N; 1992; R.L.S. 27457 from which I established the following new blazed and scribed bearing trees: (all measurements taken to a nail in side of tree)

Sugar Maple	3"	N 80° W	16.33 feet
Popple	3"	N 82° E	3.60 feet
Popple	3"	S 37° W	3.38 feet
Steel Sign Post		S 74° E	0.77 feet

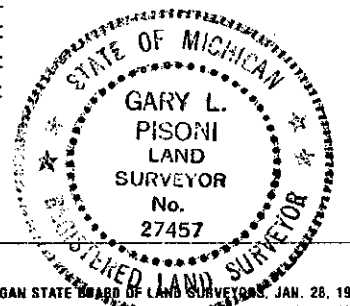

Signed by Gary L. Pisoni Date 1/28/93
Surveyor's Michigan License No. 27457