

# SURVEY & REMONUMENTATION

JAN 22 1998

## SECTION

### LAND CORNER RECORDATION CERTIFICATE Filing Requirement of Act 74, Mich. P.A. 1970

For corners in  
Gogebic

(County)

Located In:

Corner Code #

1. Public Land Survey

Section 17 44W 39W

D-5

T	R	
T	R	
T	R	
T	R	
S	T	R
S	T	R
S	T	R
S	T	R

2. Property Controlling  
in Section

3. Miscellaneous  
Property in Sec.

4. Lot No. \_\_\_\_\_, Recorded Plat \_\_\_\_\_  
5. Private Claims \_\_\_\_\_  
1/4 corner to Section 8 & 17, T44N, R39W

John R. Garske

October 23, 1997

I, \_\_\_\_\_, in a field survey on \_\_\_\_\_, 19\_\_\_\_ do hereby state that under requirements of P.A. 74, Michigan P.A. of 1970, the corner points mentioned in lines 1 and 2 above were in conformance with regulations and rules therefore as required in the current manual of survey instructions of the United States Department of the Interior, Bureau of Land Management or by a decree of a Court of Law and for that the corner points mentioned in lines 3, 4 and 5 above were in conformance with the rules of the Michigan Board of Land Surveyors or by a Decree of a Court of Law; established, re-established, monumented, recovered, found as expressed below:

NOTE: Not more than 2 corners, all in the same town and range, may be recorded on this certificate.

Register's Office }  
Gogebic County } ss.

Received for record the  
24<sup>th</sup> day of NOVEMBER  
A. D. 1997...at 11:40 o'clock  
A m., and recorded in  
Liber 6 of CORNERS  
on page 257  
Rhonda Collins, Deputy  
Register of Deeds

Register of Deeds Stamp & File Number

	A	B	C	D	E	F	G	H	I	J	K	L	M
1													
2	6		5		4		3		2		1		
3													
4	7		8		9		10		11		12		
5													
6	18		17		16		15		14		13		
7													
8	19		20		21		22		23		24		
9													
10	30		29		28		27		26		25		
11													
12	31		32		33		34		35		36		
13													

A. Description of original monument and accessories and/or subsequent restoration:

Original corner set by Wells Burt, D.S. in 1851, from which:  
Y. Birch 14" S87°W 30 links  
Lynn 16" N82°W 15 links

1988 - corner reestablished by Gary Pisoni, P.S. 27457 in the center of E. Duck Lake Road. He set the corner using 1940's era surveys by C. Banks RLS and Paul Tuttle, RLS using existing monuments found. He recorded the corner in Liber 3, page 141. Corner accessories are noted below.

B. Description of corner evidence found and/or method applied in restoring or reestablishing corner:


I found the aluminum monument set by Gary Pisoni in 1988 ripped up and bent over with the cap ripped off. I removed the monument from the road and reset the corner from the accessories he established which are all in good condition. I set a 5/8" dia. x 30" long iron rod with a 3 1/4" brass cap stamped to identify the corner. I recessed the cap 3" below the pavement.

(Research on file)

PEER GROUP APPROVED  
Richard L. Deakin 11/11/97  
COUNTY REPRESENTATIVE

C. Description of monument for corner and accessories established to perpetuate locating the position of the corner:

Set corners as noted below from which:  
R.M. 2" x 30" al. mon. - east - 21.97 feet (existing)  
Utility Pole #81-25059 N87°E 24.87 feet (existing)  
10" Sugar Maple S62°E 62.50 feet (existing)  
20" Sugar Maple S53°W 36.59 feet (existing)  
Metal Sign Post East 21.97 feet (existing)  
1 1/2" Iron Pipe N39°W 37.60 feet (new)

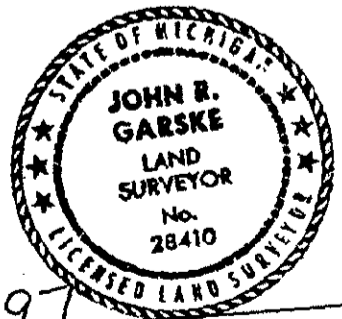

Signed by

Surveyor's Michigan License No.

*John R. Garske*  
28410

Date

11/11/97