

LAND CORNER RECORDATION CERTIFICATE
Filing Requirement of Act 74, Mich. P.A. 1970

For corners in

Register's Office }
 Gogebic County } ss.

Received for record the
2ND day of JUNE
 A. D. 19 at 10:20 o'clock
A m., and recorded in
 Liber 7 of CORNER
 at page 347
Cheryl Ruppe, Dep.
 Register of Deeds State of Michigan
 Number

Gogebic Located In: Corner Code #
 (County)

1. Public Land Survey T44N R 39W E-11
 T R
 T R
 T R
 T R

2. Property Controlling S T R
 in Section S T R

3. Miscellaneous S T R
 Property in Sec. S T R

SURVEY & MONUMENTATION
JAN 05 2001

SECTION

4. Lot No. _____, Recorded Plat _____
 5. Private Claims _____
 Section Corner common to Sections 28, 29, 32 & 33.

I, John R. Garske, in a field survey on April 10, 2000 do hereby state that under requirements of P.A. 74, Michigan P.A. of 1970, the corner points mentioned in lines 1 and 2 above were in conformance with regulations and rules therefore as required in the current manual of survey instructions of the United States Department of the Interior, Bureau of Land Management or by a decree of a Court of Law and /or that the corner points mentioned in lines 3, 4 and 5 above were in conformance with the rules of the Michigan Board of Land Surveyors or by a Decree of a Court of Law; established, re-established, monumented, recovered, found as expressed below:

A	B	C	D	E	F	G	H	I	J	K	L	M
1												
2	6		5		4		3		2		1	
3												
4	7		8		9		10		11		12	
5												
6	16		17		16		15		14		13	
7												
8	19		20		21		22		23		24	
9												
10	30		29		28		27		26		25	
11												
12	31		32		33		34		35		36	
13												

NOTE: Not more than 2 corners, all in the same town and range, may be recorded on this certificate.

A. Description of original monument and accessories and/or subsequent restoration:

Corner established by Wells Burt, U.S. Deputy Surveyor, in 1851.

Original Bearing Trees: 24" White Pine N 56° E 42 Links
 30" White Pine S 80° W 89 links

-1961 Corner set by Donald Lappala (RLS 12585), recorded in Liber 1, page 9,1962. Set a 3/4" x 13" long galvanized iron pin at corner.

Witnesses:
 10" Black Oak N29°W 33.7 feet
 17" Red Pine S45°E 44.2 feet
 6" Black Oak N68°W 43.0 feet
 Witness Corner East 21.9 feet

Record Research on File.

B. Description of corner evidence found and/or method applied in restoring or reestablishing corner:


I found a 3/4" x 13" galvanized iron pin 6" below the surface of the road as set by Lappala in 1962. I also found an erroneous 1 1/2" iron pipe with a 6" nail placed in the center of pipe, 3" below surface, S 34°-40'-51"E, 2.63 feet from Lappala's pin. I also found a reference monument, 2" iron pipe with brass cap, set by Lappala to the East of the gravel road in which the above objects were found. I found three bearing trees established by Lappala in good condition.

DEED GROUP APPROVED
Richard R. Dreda 5/25/00
 COUNTY REGISTER

C. Description of monument for corner and accessories established to perpetuate locating the position of the corner:

I accepted the above described 3/4" x 13" galvanized iron pin set and recorded by Don Lappala in 1961 as the proper corner location and established the following witnesses: Set nails in trees.

8" Sugar Maple S 51° W 45.52 Feet (New)
 24" Red Pine S 43° E 44.31 Feet (Existing)
 8" Oak N 67° W 43.10 Feet (Existing)
 12" Oak N 26° W 33.71 Feet (Existing)
 Reference Monument East 21.90 Feet (Existing)
 (3/4" brass cap on 2" iron pipe)
 S.S.P.-0.38

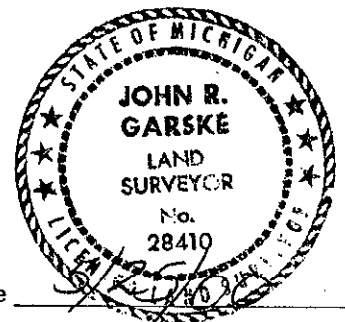

Signed by John R. Garske
 Surveyor's Michigan License No. 28410

Date _____