

SURVEY & REMONUMENTATION

AUG 08 1997

LAND CORNER RECORDATION CERTIFICATE
Filing Requirement of Act 74, Mich. P.A. 1970

Register's Office }
 Gogebic County } ss.

For corners in COMMISSION
Gogebic
 (County)

Located In: _____ Corner Code # _____

- | | | | | |
|------------------------------------|---------|------|-------|------|
| 1. Public Land Survey | Sec. 32 | T44N | R 39W | E-12 |
| | | T | R | |
| | | T | R | |
| | | T | R | |
| 2. Property Controlling in Section | S | T | R | |
| | S | T | R | |
| 3. Miscellaneous | S | T | R | |
| Property in Section | S | T | R | |

Received for record the
16th day of MAY
 A. D. 1997 at 11:20 o'clock
A m., and recorded in
 Lib. 6 of CORNERS
 OF PAGE 128
Ramona L. Collins, Deputy
 Register of Deeds

Register of Deeds Stamp & File Number

4. Lot No. _____, Recorded Plat _____
 5. Private Claims _____

One-Quarter Corner of Sec. 32 and Sec. 33

I, John R. Garske, in a field survey on December 2, 1996, do hereby certify that under requirements of P.A. 74, Michigan P.A. of 1970, the corner points mentioned in lines 1 and 2 above were in conformance with regulations and rules therefore as required in the current manual of survey instructions of the United States Department of the Interior, Bureau of Land Management or by a decree of a Court of Law and/or that the corner points mentioned in lines 3, 4 and 5 above were in conformance with the rules of the Michigan Board of Professional Surveyors or by a Decree of a Court of Law; established, re-established, monumented, re-monumented, recovered, found as expressed below:

A	B	C	D	E	F	G	H	I	J	K	L	M
2	6	5	4	3	2							
3												
4	7	8	9	10	11	12						
5												
6	18	17	16	15	14	13						
7												
8	19	20	21	22	23	24						
9												
10	30	29	28	27	26	25						
11												
12	31	32	33	34	35	36						
13												

NOTE: Not more than 4 corners, all in the same town and range, may be recorded on this certificate.

A. Description of original monument and accessories and/or subsequent restoration:

- Original corner established by Wells Burt, U.S. Deputy Surveyor on August 27, 1851.
- Original Corner: Wood post
- Original Bearing Trees: White pine 18" N83°E 17 links (11.2 feet) White pine 14" S62°W 47 links (31.02 feet)
- In 1982 Gary Pisoni, found 3 metal objects.
- In 1988 Gary Pisoni, Land Surveyor, found the same 3 metal objects, a 1 1/4" iron pipe, 1/2" iron pipe and a 1" drillrod was near midway position and it best represented the location of the one-quarter corner position.
- Gary Pisoni; set a 2" x 30" long aluminum pipe monument with a 3" aluminum cap stamped; T44N, R39W; 1/4; S-32; S-33; 1982; RLS 27457; Red Pine 17" N 65°E - 15.47 feet. Jack Pine 14" S39°E 46.12 feet. Red Pine 21" N39°W - 28.71 feet. Iron pin 1/2" N26° - 21'W - S7.96 feet. Iron pipe 1 1/4" N24° - S4'W - 55.97 feet. Corner Recorded L3, pg. 265.

B. Description of corner evidence found and/or method applied in restoring or reestablishing corner:

- Found a 2 1/2" iron pipe with a 3" aluminum cap stamped: T44N, R39W; 1/4; S33; 1982; RLS 27457. Set by Gary Pisoni, RLS.


(Record Research on File)

PEER GROUP APPROVED
Richard L. Decker 5/12/97
 COUNTY REPRESENTATIVE

C. Description of monument for corner and accessories established to perpetuate locating the position of the corner:

- Accepted the above monument from which I established the following bearing trees and reference objects:
 (existing) 18" Red Pine - N66°E - 15.45 feet
 (existing) 14" White Pine - S36°E - 46.13 feet
 (existing) 20" Red Pine - N38°W - 28.72 feet
 (existing) 6' Steel sign rail - due east - 0.87 feet

Signed by John R. Garske
 Surveyor's Michigan License No. 28410

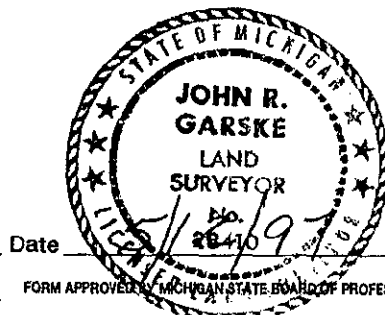

Date 5/12/97
 FORM APPROVED BY MICHIGAN STATE BOARD OF PROFESSIONAL SURVEYORS, JAN. 28, 1971
 REVISED MAY 14, 1975
 REVISED JAN., 1993