

SURVEY & REMONUMENTATION

AUG 08 1997

COMMISSION

LAND CORNER RECORDATION CERTIFICATE
Filing Requirement of Act 74, Mich. P.A. 1970

For corners in Gogebic Located In: _____ Corner Code # _____
 (County)

1. Public Land Survey	Sec. 10	T44N	R 39W	G-3
		T _____	R _____	_____
		T _____	R _____	_____
		T _____	R _____	_____
2. Property Controlling in Section	S _____	T _____	R _____	_____
	S _____	T _____	R _____	_____
3. Miscellaneous Property in Section	S _____	T _____	R _____	_____
	S _____	T _____	R _____	_____

Register's Office }
 Gogebic County } ss.

Received for record the
16TH day of MAY
 A. D. 1997 at 11:20 o'clock
A m., and recorded in
 Liber 6 of CORNERS
 on page 129
Ramona L. Collins, Deputy
 Register of Deeds

Register of Deeds Stamp & File Number

4. Lot No. _____, Recorded Plat _____
 5. Private Claims _____

Section corner 3, 4, 9 & 10, T44N, R39W.

I, John R. Garske, in a field survey on April 15th, 1997, do hereby certify that under requirements of P.A. 74, Michigan P.A. of 1970, the corner points mentioned in lines 1 and 2 above were in conformance with regulations and rules therefore as required in the current manual of survey instructions of the United States Department of the Interior, Bureau of Land Management or by a decree of a Court of Law and/or that the corner points mentioned in lines 3, 4 and 5 above were in conformance with the rules of the Michigan Board of Professional Surveyors or by a Decree of a Court of Law; established, re-established, monumented, re-monumented, recovered, found as expressed below:

NOTE: Not more than 4 corners, all in the same town and range, may be recorded on this certificate.

A	B	C	D	E	F	G	H	I	J	K	L	M
2	6	5	4	3	2	1						
3												
4	7	8	9	10	11	12						
5												
6	18	17	16	15	14	13						
7												
8	19	20	21	22	23	24						
9												
10	30	29	28	27	26	25						
11												
12	31	32	33	34	35	36						
13												

A. Description of original monument and accessories and/or subsequent restoration:

- Original corner established by Wells Burt U.S. Deputy Surveyor in 1851
 Original bearing trees: Hemlock 20" S68°E 36 links
 Sugar Maple 12" S86° W 53 links
- In 1964 Donald Lappala RLS 12585, restored corner position at record bearing and distance from the stump remains of the two original bearing trees. Corner position further verified by measurement to recoverable natural features to the north. Lappala then set a 2" diameter by 5 foot long pipe with 3" bronze cap stamped: T44N, R39W; S-3, 5-4, 5-9, 5-10; RLS 12585; 1964 Rec L1, pg. 55. From which he established the following. (see reverse side)

B. Description of corner evidence found and/or method applied in restoring or reestablishing corner:

Found a 2" diameter iron pipe with 3" bronze cap set by Donald Lappala. Found bearing tree in good condition, a twin sugar maple and (2) reference objects which area power pole and wood sign post.

(Record Research on File)


PEER GROUP APPROVED
Richard L. Drahn 5/12/97
COUNTY REPRESENTATIVE

C. Description of monument for corner and accessories established to perpetuate locating the position of the corner:

I accepted the above mentioned monument and witnesses established by Richard Drahn and Gary Pisoni and I then established the following reference object:

6' steel sign rail - due south - 1.70 feet.

Signed by John R. Garske Date 5/12/97
 Surveyor's Michigan License No. 28410

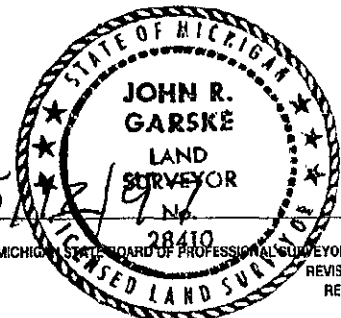

FORM APPROVED BY MICHIGAN STATE BOARD OF PROFESSIONAL SURVEYORS, JAN. 28, 1971
 REVISED MAY 14, 1975
 REVISED JAN., 1983

A. Continued.

- 9" Sugar maple N 61° - 30'W - 40.6 feet
- 10" Sugar Maple N 51-00'E - 47.5 feet
- 6" Sugar maple S53°-30'W - 40.8 feet

- In 1985, Richard Drahn, RLS 21564, recovered the monument and established new bearing trees:
 - 10" Red Maple - N77°E - 36.16 feet
 - Power pole #35-577-1482 - N 27°E- 50.02 feet
 - 4" x 4" x 7' Cedar sign post - S87°E - 2.89 feet
 } (all found in good condition)

- In years 1986-1988 Gary Pisoni, RLS 27457 did a plat of survey for the U.S. Forest Service of Sections 3, 4, 9, 10, T44N R39W and has been recorded at the Register of Deeds in Gogebic County. He notes the corner was recorded with the Gogebic County records in Liber 1, pg. 191 on Sept. 7, 1967.

**SURVEY &
REMONUMENTATION**

AUG 08 1997

COMMISSION