

SURVEY & REMONUMENTATION

AUG 08 1997

COMMISSION LAND CORNER RECORDATION CERTIFICATE

Filing Requirement of Act 74, Mich. P.A. 1970

Register's Office }
Gogebic County } ss.

Received for record the
16TH day of MAY

A. D. 1997 at 11:20 o'clock

A m., and recorded in

Liber 6 of CORNERS

Page 130
Ramona Collins Deputy
Register of Deeds


Register of Deeds Stamp & File Number

For corners in	Gogebic	Located In:	Corner Code #
	(County)		
1. Public Land Survey	Sec. 10	T <u>44N</u> R <u>39W</u>	<u>G-4</u>
		T _____ R _____	_____
		T _____ R _____	_____
		T _____ R _____	_____
2. Property Controlling in Section	S _____	T _____ R _____	_____
	S _____	T _____ R _____	_____
3. Miscellaneous Property in Section	S _____	T _____ R _____	_____
	S _____	T _____ R _____	_____

4. Lot No. _____, Recorded Plat _____
5. Private Claims _____

Quarter corner 9, 10 T44N, R39W.

I, John R. Garske, in a field survey on April 15th, 1997, do hereby certify that under requirements of P.A. 74, Michigan P.A. of 1970, the corner points mentioned in lines 1 and 2 above were in conformance with regulations and rules therefore as required in the current manual of survey instructions of the United States Department of the Interior, Bureau of Land Management or by a decree of a Court of Law and/or that the corner points mentioned in lines 3, 4 and 5 above were in conformance with the rules of the Michigan Board of Professional Surveyors or by a Decree of a Court of Law; established, re-established, monumented, re-monumented, recovered, found as expressed below:

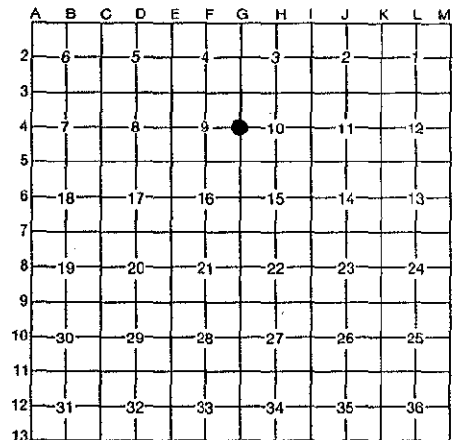

NOTE: Not more than 4 corners, all in the same town and range, may be recorded on this certificate.

A. Description of original monument and accessories and/or subsequent restoration:

- Original corner established by Wells Burt, U.S. Deputy Surveyor on August 25, 1851.
- Original bearing trees: Cedar 10" N50°W 14 links Cedar 6" S72° links
- Corner position re-established by E. Kazianka, RLS 14765, on 10/31/68, by mathematical means. From which he established: 7" cedar N41°W S4.9 feet (cut and dead, 6/18/85)
- Corner position recovered by Donald Lappala, RLS 1285, on 9/9/70, from which he established witnesses: 9" yellow birch N72°E 66.9 feet. Wisc-Mich power pole #8072 S04°W 17.7 feet (cut 6/18/85)
- In 1985, Richard Drahn, RLS 21564, found Kazianka's 1" iron pipe with a 4" aluminum cap, stamped: Kimberly Clark Corp.; Kazianka, RLS 14765; 10/31/68; T44N, R39W; 1/4 9/10. Drahn then established the following witnesses: Wis.- Mich Power Pole #73-1516 N09°W - 6.92 feet 4" Cedar Sign Post S48°W 1.18 feet. Rec. L2, pg. 762. (see reverse side)

B. Description of corner evidence found and/or method applied in restoring or reestablishing corner:


I found the monument set by Kazianka as described above, and the witnesses that were established by Richard Drahn and Gary Pisoni which were all in good condition, I checked the witnesses distances where one was off and I noted the differences below under new witnesses.

(Record Research on File)

C. Description of monument for corner and accessories established to perpetuate locating the position of the corner:

I accepted the above mentioned monument and witnesses and from which I established the following witnesses:
6' steel sign rail - S 78°E - 2.73 feet
(Existing) 8" Red maple - N48°W - 69.97 feet (m) 69.49 (R)

PEER GROUP APPROVED
Richard L. Drahn 5/12/97
COUNTY REPRESENTATIVE

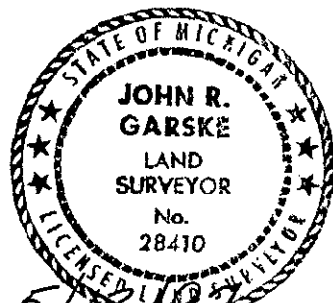

Signed by John R. Garske
Surveyor's Michigan License No. 28410

Date 5/12/97

FORM APPROVED BY MICHIGAN STATE BOARD OF PROFESSIONAL SURVEYORS, JAN. 28, 1971
REVISED MAY 14, 1975
REVISED JAN., 1983

- In years 1986 - 1988, Gary Pisoni, RLS 27457, did a Plat of Survey for the U.S. Forest Service of Sections 3,4,9, &10, T44N, R39W. He established the following witnesses: Yellow Birch 10" N73°E - 66.93 feet. Red Maple 12" S76°E 42.78 feet. Red Maple 8"E N48°W 69.49 feet.

**SURVEY &
REMONUMENTATION**

AUG 08 1997

COMMISSION