

SURVEY & REMONUMENTATION

AUG 08 1997

COMMISSION

LAND CORNER RECORDATION CERTIFICATE
Filing Requirement of Act 74, Mich. P.A. 1970

For corners in Gogebic (County) Located In: Corner Code #

| | | | | |
|--------------------------------------|---------|------|-------|-----|
| 1. Public Land Survey | Sec. 10 | T44N | R 39W | H-5 |
| | | T | R | |
| | | T | R | |
| | | T | R | |
| 2. Property Controlling in Section | S | T | R | |
| | S | T | R | |
| 3. Miscellaneous Property in Section | S | T | R | |
| | S | T | R | |

Register's Office } ss.
Gogebic County }

Received for record the 16TH day of MAY A. D. 1997 at 11:20 o'clock A M., and recorded in 6 of CORNERS on page 132.
Ramona L. Collins, Deputy
Register of Deeds

Register of Deeds Stamp & File Number

4. Lot No. _____, Recorded Plat _____
5. Private Claims _____

Quarter corner sections 10 & 15 T44N, R39W.

I, John R. Garske, in a field survey on April 15 th, 19 97, do hereby certify that under requirements of P.A. 74, Michigan P.A. of 1970, the corner points mentioned in lines 1 and 2 above were in conformance with regulations and rules therefore as required in the current manual of survey instructions of the United States Department of the Interior, Bureau of Land Management or by a decree of a Court of Law and/or that the corner points mentioned in lines 3, 4 and 5 above were in conformance with the rules of the Michigan Board of Professional Surveyors or by a Decree of a Court of Law; established, re-established, monumented, re-monumented, recovered, found as expressed below:

| | | | | | | | | | | | | |
|----|----|----|----|----|----|----|---|---|---|---|---|---|
| A | B | C | D | E | F | G | H | I | J | K | L | M |
| 2 | 6 | 5 | 4 | 3 | 2 | 1 | | | | | | |
| 3 | | | | | | | | | | | | |
| 4 | 7 | 8 | 9 | 10 | 11 | 12 | | | | | | |
| 5 | | | | | | | | | | | | |
| 6 | 18 | 17 | 16 | 15 | 14 | 13 | | | | | | |
| 7 | | | | | | | | | | | | |
| 8 | 19 | 20 | 21 | 22 | 23 | 24 | | | | | | |
| 9 | | | | | | | | | | | | |
| 10 | 30 | 29 | 28 | 27 | 26 | 25 | | | | | | |
| 11 | | | | | | | | | | | | |
| 12 | 31 | 32 | 33 | 34 | 35 | 36 | | | | | | |
| 13 | | | | | | | | | | | | |

NOTE: Not more than 4 corners, all in the same town and range, may be recorded on this certificate.

A. Description of original monument and accessories and/or subsequent restoration:

- Original corner established by Wells Burt, U.S. Deputy Surveyor on Sept. 1., 1851.
- Original bearing trees : Cedar 9" N16°E 10 links (6.60feet) Cedar 4" S28°W 12 links (7.92 feet)
- Corner position monumented by E. Kazianka, RLS 14765 on 10/30/68; with a 1" diameter iron pipe with 4" aluminum cap stamped to indicate the corner location. He established the following new bearing trees:
7" sugar maple - N22°E - 254 feet. 7" sugar maple- S51°W - 6.5 feet
- Donald Lappala, RLS 12585 recovered Kazianka's monument on 8/25/70 and established new bearing trees:
10" Sugar maple - N 48° W - 15.7 feet
12" yellow birch - N 73°E - 24.2 feet (destroyed)
4" x 4" x 7" cedar post - S54°E - 3.8 feet (see reverse side)

B. Description of corner evidence found and/or method applied in restoring or reestablishing corner:

I found a Kimberly Clark monument as set by Kazianka and found the Cedar Post and sugar maple bearing tree in good condition, recovered the yellow birch stump which the distance checked and found Pisoni's witnesses in good condition.

(Record Research on File)

PEER GROUP APPROVED
Richard L. Deahn 5/12/97
COUNTY REPRESENTATIVE


C. Description of monument for corner and accessories established to perpetuate locating the position of the corner:

I accepted the above mentioned monument and established the following witnesses and reference objects:

- (existing) 10" sugar maple - S55°W - 6.48 feet
- (existing) 14" sugar maple - N51°W - 15.70 feet
- (existing) 12" sugar maple - N23° E - 25.38 feet
- (existing) Wood sign post - S46°E - 3.8 feet
- 6' steel sign post - due east - 2.39 feet

Signed by John R. Garske
Surveyor's Michigan License No. 28410

Date 5/12/97

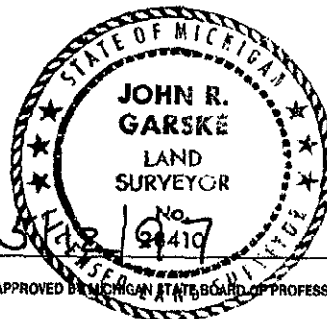

FORM APPROVED BY MICHIGAN STATE BOARD OF PROFESSIONAL SURVEYORS, JAN. 28, 1971
REVISED MAY 14, 1975
REVISED JAN., 1983

A. Continued

- On 6/11/85, Richard Drahn, RLS, 21564, recorded the corner position in 1986, L2, pg. 764.
- In years 1986-1988, Gary Pisoni, RLS 27457, did a plat of survey for the U.S. Forest Service and has been recorded at the Register of Deeds in Gogebic County. Pisoni found the witnesses to be in good condition and he established the following witnesses:
 - 8" Sugar maple S55°W - 6.48 feet
 - 10" Sugar Maple - N23° - 25.38 feet

SURVEY &
REMONUMENTATION

AUG 08 1997

COMMISSION