

**SURVEY & REMONUMENTATION**

**JAN 22 1998**

**SECTION**

**LAND CORNER RECORDATION CERTIFICATE**  
Filing Requirement of Act 74, Mich. P.A. 1970

Register's Office }  
Gogebic County } ss.

For corners in  
Gogebic  
(County)

Located In:	Corner Code #
Section 13, 44W 39W	L-7
T ___ R ___	_____
T ___ R ___	_____
T ___ R ___	_____
T ___ R ___	_____
S ___ T ___ R ___	_____
S ___ T ___ R ___	_____
S ___ T ___ R ___	_____
S ___ T ___ R ___	_____

- 1. Public Land Survey
- 2. Property Controlling in Section
- 3. Miscellaneous Property in Sec.

Received for record the  
24<sup>th</sup> day of November  
A. D. 1997 at 11:40 o'clock  
A m., and recorded in  
Liber 6 of CORNERS  
on page 260  
*Kimona Collins, Deputy*  
Register of Deeds

Register of Deeds Stamp & File Number

- 4. Lot No. \_\_\_\_\_, Recorded Plat \_\_\_\_\_
- 5. Private Claims \_\_\_\_\_

1/4 corner to section 13 & 24, T44N, R39W

I, John R. Garske, in a field survey on October 7, 19 97 do hereby state that under requirements of P.A. 74, Michigan P.A. of 1970, the corner points mentioned in lines 1 and 2 above were in conformance with regulations and rules therefore as required in the current manual of survey instructions of the United States Department of the Interior, Bureau of Land Management or by a decree of a Court of Law and /or that the corner points mentioned in lines 3, 4 and 5 above were in conformance with the rules of the Michigan Board of Land Surveyors or by a Decree of a Court of Law; established, re-established, monumented, recovered, found as expressed below:

	A	B	C	D	E	F	G	H	I	J	K	L	M
1													
2	6		5		4		3		2		1		
3													
4	7		8		9		10		11		12		
5													
6	18		17		16		15		14		13		
7													
8	19		20		21		22		23		24		
9													
10	30		29		28		27		26		25		
11													
12	31		32		33		34		35		36		
13													

NOTE: Not more than 2 corners, all in the same town and range, may be recorded on this certificate.

**A. Description of original monument and accessories and/or subsequent restoration:**

Original corner set by Wells Burt, D.S. in 1851 from which;  
Cedar 9" S65°W 17 links  
Cedar 18" N21°W 25 links  
1961 - Corner monumented by Donald Lappala RLS 12585 from a found cedar post set by F.C. Serena using GLO natural future ties. He set: 6" cedar - N81°W, 6" Balsam, S73°E - 7" cedar S05°E - 24.3'. Corner recorded L1, pg. 25.  
3.3' 19.2'

**B. Description of corner evidence found and/or method applied in restoring or reestablishing corner:**


I found the monument set by Lappala in 1961 consisting of a 2" dia x 5' long gal. pipe with a 3" brass cap stamped to identify the corner. I updated his bearing trees as noted below.

(Research on file)

**PEER GROUP APPROVED**  
*Richard L. Drahm 11/11/97*  
**COUNTY REGISTRAR**

**C. Description of monument for corner and accessories established to perpetuate locating the position of the corner:**

Found Lappala's monument as noted above from which I established the following:  
12" cedar N82°N 3.21 feet (existing)  
16" Balsam S75°E 19.26 feet (existing)  
14" Cedar S05°E 24.33 feet (existing)  
6' steel sign rail N50°E 3.08 feet (existing)

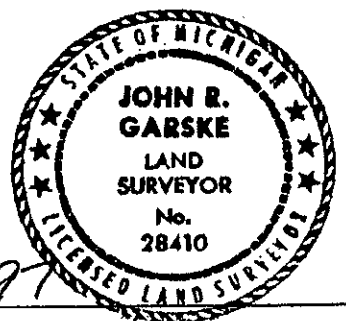

Signed by John R. Garske  
Surveyor's Michigan License No. 28410

Date 11/11/97