

MAR 02 2000

SECTION

LAND CORNER RECORDATION CERTIFICATE  
Filing Requirement of Act 74, Mich. P.A. 1970

Register's Office }  
Gogebic County } ss.

Received for record this  
21<sup>st</sup> day of JULY  
A. D. 1999 at 1:05 o'clock  
P M., and recorded in  
Liber 7 of CORNERS  
on page 166  
Ramona Collins Deputy  
Register of Deeds

For corners in  
Gogebic

Located In:	Corner Code #
Section 19 44N 39W C-8/9	
T R	
T R	010
T R	
T R	
S T R	
S T R	
S T R	
S T R	

1. Public Land Survey

2. Property Controlling  
In Section

3. Miscellaneous  
Property in Sec.


4. Lot No. \_\_\_\_\_, Recorded Plat \_\_\_\_\_

5. Private Claims \_\_\_\_\_

South Meander corner common to sections 19, 20, T44N, R39W

I, John R. Garske in a field survey on January 5, 1999 do hereby state that under requirements of P.A. 74, Michigan P.A. of 1970, the corner points mentioned in lines 1 and 2 above were in conformance with regulations and rules therefore as required in the current manual of survey instructions of the United States Department of the Interior, Bureau of Land Management or by a decree of a Court of Law and/or that the corner points mentioned in lines 3, 4 and 5 above were in conformance with the rules of the Michigan Board of Land Surveyors or by a Decree of a Court of Law; established, re-established, monumented, recovered, found as expressed below:

NOTE: Not more than 2 corners, all in the same town and range, may be recorded on this certificate.

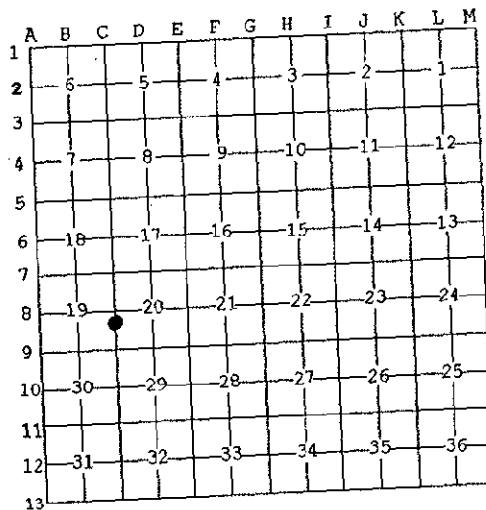

A. Description of original monument and accessories and/or subsequent restoration:

Original survey by Wells Burt, D.S. in 1851.  
 Original Bearing Trees: 8" cedar S17°W 31 links 37 links  
 8" cedar S12°E  
 1923-corner restored by General Land Office and established: 16" hemlock S41°-30'W 16.4 feet 25 links.  
 1961-Donald Lapplal, RLS #12585 found G.L.O. corner: a 1 1/2" x 3' long galvanized iron pipe, capped with a 2 1/2" brass cap stamped to identify the corner from which he established:  
 10" hemlock S72°E 46.4 feet (70 links)  
 16" hemlock S41°W 16.4 feet (25 links)  
 (1923 bearing tree) (corner recorded liber 1, page 16)

U.S.F.S. LIBER, PAGE PA - 5

B. Description of corner evidence found and/or method applied in restoring or reestablishing corner:

I found the monument and accessories as described above, on the south end of Duck Lake in good condition. I set nails in new bearing trees and recorded new ties as noted below.

(Research on file)

DEED GROUP APPROVED

Richard H. Neal 7/10/99  
COUNTY REPRESENTATIVE

C. Description of monument for corner and accessories established to perpetuate locating the position of the corner:

Monument found as described above from which I established the following witnesses:		
Wood post	N73°E	1.17 feet
6" cedar	S38°E	15.35 feet
10" cedar	S30°W	12.00 feet
6" spruce	N42°W	4.28 feet
Steel sign rail	S73°W	20 feet

Signed by John R. Garske  
Surveyor's Michigan License No. 28410

Date 7/19/99

