

LAND CORNER RECORDATION CERTIFICATE
Filing Requirement of Act 74, Mich. P.A. 1970

For corners in

<u>Gogebic</u> (County)	Located In:	Corner Code #
1. Public Land Survey	T 44N R 41W	B-3
	T _____ R _____	_____
	T _____ R _____	_____
	T _____ R _____	_____
2. Property Controlling in Section	S _____ T _____ R _____	_____
	S _____ T _____ R _____	_____
3. Miscellaneous Property in Sec.	S _____ T _____ R _____	_____
	S _____ T _____ R _____	_____

Register's Office } ss.
Gogebic County }

Received for record the
18th day of APRIL
A. D. 1994 at 1:20 o'clock
P m., and recorded in
Liber 5 of CORNERS
on page 23
Betty Saari Deputy
Register of Deeds

Register of Deeds Stamp & File Number

4. Lot No. _____, Record of _____
5. Private Claims **PEER GROUP** **Approved**
Richard P. Decker 4/7/94

A	B	C	D	E	F	G	H	I	J	K	L	M
2	6	5	4	3	2	1						
3												
4	7	8	9	10	11	12						
5												
6	18	17	16	15	14	13						
7												
8	19	20	21	22	23	24						
9												
10	30	29	28	27	26	25						
11												
12	31	32	33	34	35	36						
13												

I, Gary L. Pisoni, in a field survey on August 10, 19 92, do hereby certify that under requirements of P.A. 74, Michigan P.A. of 1970, the corner points mentioned in lines 1 and 2 above were in conformance with regulations and rules therefore as required in the current manual of survey instructions of the United States Department of the Interior, Bureau of Land Management or by a decree of a Court of Law and/or that the corner points mentioned in lines 3, 4 and 5 above were in conformance with the rules of the Michigan Board of Land Surveyors or by a Decree of a Court of Law; established, re-established, monumented, re-monumented, recovered, found as expressed below.

NOTE: Not more than 4 corners, all in the same town and range, may be recorded on this certificate.

A. Description of original monument and accessories and/or subsequent restoration:

Original Corner established by Algernon Merryweather, U.S. Deputy Surveyor on July 11, 1852.
Original Corner: Wood post
Original Bearing trees:
Birch 6" S 20° E 14 links (9.24 feet)
Balsam 6" N 45° W 42 links (27.72 feet)


B. Description of corner evidence found and/or method applied in restoring or reestablishing corner:

No original corner evidence found. Corner restored by using single proportionate measurement methods on line between the Southeast and Southwest Section corners of Section 6.

PEER GROUP **Approved**

C. Description of monument for corner and accessories established to perpetuate locating the position of the corner:

At the corner position, I set a 3/4" outside diameter by 7 feet long aluminum rod monument with a 3" cast aluminum cap, stamped to read: T44N, R41W, 1/4, S-6, S-7, 1991, RLS- 27457 from which I established the following new blazed and scribed bearing trees: (all measurements taken to a nail in side of tree)
Tamarack 6" N 06° W 12.78 feet
Tamarack 7" S 35° E 21.93 feet
Black Spruce 6" S 61° W 15.23 feet
Steel Sign Post East 1.12 feet

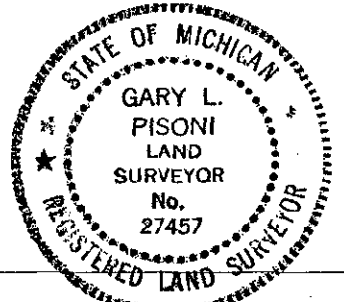

Signed by Gary L. Pisoni Date 3-22-94
Surveyor's Michigan License No. 27457