

LAND CORNER RECORDATION CERTIFICATE  
Filing Requirement of Act 74, Mich. P.A. 1970

Register's Office }  
Gogebic County } ss.

Received for record the  
10<sup>th</sup> day of APRIL  
A. D. 1994 at 1:20 o'clock  
P. m., and recorded in  
Liber F of CORNERS  
on page 27  
Betty Larric Deputy  
Register of Deeds

For corners in Gogebic (County)	Located In:	Corner Code #
1. Public Land Survey	T 44N R 41W	c-4
	T R	
	T R	
	T R	
2. Property Controlling in Section	S T R	
	S T R	
3. Miscellaneous Property in Sec.	S T R	
	S T R	

Register of Deeds Stamp & File Number

4. Lot No. \_\_\_\_\_, Recorded Plat  
5. Private Claims \_\_\_\_\_  
**BEER GROUP** Approved  
Richard L. Dreda 4/7/94

A	B	C	D	E	F	G	H	I	J	K	L	M
2	6	5	4	3	2	1						
3												
4	7	8	9	10	11	12						
5												
6	18	17	16	15	14	13						
7												
8	19	20	21	22	23	24						
9												
10	30	29	28	27	26	25						
11												
12	31	32	33	34	35	36						
13												


I, Gary L. Pisoni, in a field survey on August 10, 1992, do hereby certify that under requirements of P.A. 74, Michigan P.A. of 1970, the corner points mentioned in lines 1 and 2 above were in conformance with regulations and rules therefore as required in the current manual of survey instructions of the United States Department of the Interior, Bureau of Land Management or by a decree of a Court of Law and/or that the corner points mentioned in lines 3, 4 and 5 above were in conformance with the rules of the Michigan Board of Land Surveyors or by a Decree of a Court of Law; established, re-established, monumented, re-monumented, recovered, found as expressed below:

NOTE: Not more than 4 corners, all in the same town and range, may be recorded on this certificate.

A. Description of original monument and accessories and/or subsequent restoration:  
Original Corner established by Algernon Merryweather, U.S. Deputy Surveyor on July 11, 1852.  
Original Corner: Wood post  
Original Bearing Trees:  
Spruce 4" Corner Tree  
Spruce 3" S 25°W 20 links (13.20 feet)

B. Description of corner evidence found and/or method applied in restoring or reestablishing corner:  
No original corner evidence found. Corner restored by single proportionate measurement methods on line between the Northeast and Southeast Section corners of Section 7.

C. Description of monument for corner and accessories established to perpetuate locating the position of the corner:  
At the corner position, I set a 3/4" outside diameter by 8 feet long aluminum rod monument with a 3" cast aluminum cap, stamped to read: T44N, R41W, 1/4, S-7, S-8, 1991, RLS- 27457 from which I established the following new blazed and scribed bearing trees: (all measurements taken to a nail in side of tree)  
Tamarack 4" N 51°E 23.86 feet  
Black Spruce 4" S 20°W 11.11 feet  
Black Spruce 5" N 57°W 22.94 feet  
Steel Sign Post East 0.80 feet

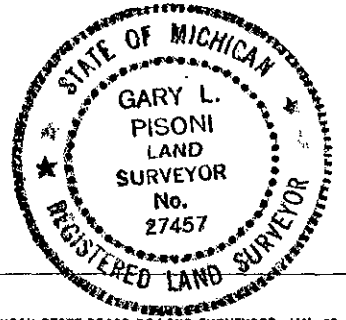

Signed by Gary L. Pisoni Date 3-22-94  
Surveyor's Michigan License No. 27457