

Register's Office }  
Gogebic County } ss.

**LAND CORNER RECORDATION CERTIFICATE**  
Filing Requirement of Act 74, Mich. P.A. 1970

Received for record the  
18<sup>th</sup> day of April  
A. D. 1994 at 1:20 o'clock  
P m., and recorded in  
Liber 5 of CORNERSS  
on page 30  
Betty Saari Deputy  
Register of Deeds

For corners in  
Gogebic  
(County)

Located In: Corner Code #

1. Public Land Survey T \_\_\_ R \_\_\_  
T \_\_\_ R \_\_\_  
T \_\_\_ R \_\_\_  
T \_\_\_ R \_\_\_

2. Property Controlling S 17 T 44N R 41W D-5  
in Section S \_\_\_ T \_\_\_ R \_\_\_

3. Miscellaneous S \_\_\_ T \_\_\_ R \_\_\_  
Property in Sec. S \_\_\_

4. Lot No. \_\_\_\_\_, Recorded Plat \_\_\_\_\_  
5. Private Claims Richard L. Deahn 4/7/94

Register of Deeds Stamp & File Number

**PEER GROUP Approved**

Corner D-5 (Quarter Corner between Sections 8 and 17)

I, Gary L. Pisoni, in a field survey on October 1, 19 91, do hereby certify that under requirements of P.A. 74, Michigan P.A. of 1970, the corner points mentioned in lines 1 and 2 above were in conformance with regulations and rules therefore as required in the current manual of survey instructions of the United States Department of the Interior, Bureau of Land Management or by a decree of a Court of Law and/or that the corner points mentioned in lines 3, 4 and 5 above were in conformance with the rules of the Michigan Board of Land Surveyors or by a Decree of a Court of Law; established, re-established, monumented, re-monumented, recovered, found as expressed below:

	A	B	C	D	E	F	G	H	I	J	K	L	M
2	6		5		4		3		2		1		
3													
4	7		8		9		10		11		12		
5													
6	13		17		16		15		14		13		
7													
8	19		20		21		22		23		24		
9													
10	30		29		28		27		26		25		
11													
12	31		32		33		34		35		36		
13													

**NOTE: Not more than 4 corners, all in the same town and range, may be recorded on this certificate.**

A. Description of original monument and accessories and/or subsequent restoration:

Original corner established by A. Merryweather, U.S. Deputy Surveyor on July 12, 1852.  
Original corner: Wood Post  
Original Bearing Trees:  
Sugar Maple 12" North 12 lks. (7.92 feet)  
Cedar 6" S 05° W 12 lks. (7.92 feet)


B. Description of corner evidence found and/or method applied in restoring or reestablishing corner:

No original corner evidence found. Corner position found marked by a 5/8" diameter iron pin set by Donald D. Lappala RLS. Lappala re-established the corner position by single proportionate measurement method on line between the Northeast and Northwest Section corners of Section 17. Set an aluminum pipe monument over the top of iron pin as described below.

C. Description of monument for corner and accessories established to perpetuate locating the position of the corner:

At the corner position, I set a 2" diameter by 30" long split base aluminum pipe monument with a 3" cast aluminum cap, stamped to read: T44N, R41W, S-8, 1/4, S-17, 1991, RLS- 27457 from which I established the following new blazed and scribed bearing trees: (all measurements taken to a nail in side of tree)

Sugar Maple	6"	N 12° E	33.58 feet
Red Maple (clump)	8"	S 36° W	22.60 feet
Hemlock	12"	S 18° E	28.21 feet
Steel Sign Post		South	1.02 feet

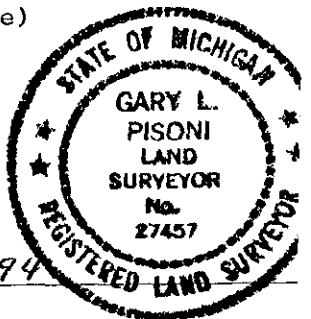

Signed by Gary L. Pisoni Date March 11<sup>th</sup> 1994  
Surveyor's Michigan License No. 27457