

LAND CORNER RECORDATION CERTIFICATE
 Filing Requirement of Act 74, Mich. P.A. 1970

Register's Office }
 Gogebic County } ss.

Received for record the
17th day of OCTOBER
 A. D. 1993 at 2:50 o'clock
P m., and recorded in
 Liber 4 of CORNER
 on page 264 208

Betty Saari Deputy
 Register of Deeds

Register of Deeds Stamp & File Number

For corners in

Gogebic
 (County)

Located In: Corner Code =#

1. Public Land Survey

T ~~44~~ ^{45N} R 41W H-13
 T _____ R _____
 T _____ R _____
 T 44N R 41W H-1

2. Property Controlling in Section

S _____ T _____ R _____
 S _____ T _____ R _____

3. Miscellaneous Property in Sec.

S _____ T _____ R _____
 S _____ T _____ R _____

4. Lot No. _____, Recorded Plat _____

5. Private Claims _____

	A	B	C	D	E	F	G	H	I	J	K	L	M
2	6	5	4	3	2	1							
3													
4	7	8	9	10	11	12							
5													
6	18	17	16	15	14	13							
7													
8	19	20	21	22	23	24							
9													
10	30	29	28	27	26	25							
11													
12	31	32	33	34	35	36							
13													

I, Gary L. Pisoni, in a field survey on June 17, 19 92, do hereby certify that under requirements of P.A. 74, Michigan P.A. of 1970, the corner points mentioned in lines 1 and 2 above were in conformance with regulations and rules therefore as required in the current manual of survey instructions of the United States Department of the Interior, Bureau of Land Management or by a decree of a Court of Law and/or that the corner points mentioned in lines 3, 4 and 5 above were in conformance with the rules of the Michigan Board of Land Surveyors or by a Decree of a Court of Law, established, re-established, monumented, re-monumented, recovered, found as expressed below:

NOTE: Not more than 4 corners, all in the same town and range, may be recorded on this certificate.

A. Description of original monument and accessories and/or subsequent restoration:

Original corner established by William A. Burt, U.S. Deputy Surveyor in 1847.

Original corner: Sugar Post

Original bearing trees:

Yellow Birch	24"	N 20° E	7.26 feet (11 Links)
Sugar Maple	12"	N 64° W	29.70 feet (45 Links)

B. Description of corner evidence found and/or method applied in restoring or reestablishing corner:

No original corner evidence found. Corner restored by single proportionate measurement on line between the Southwest and Southeast section corners of Section 34.

C. Description of monument for corner and accessories established to perpetuate locating the position of the corner:

At the corner position, I set a 2" diameter by 30" long split base aluminum pipe monument with a 3" cast aluminum cap, stamped to read: T45N, R41W, 1/4, S-34, S-3, T44N, 1992, RLS 27457 from which I established the following new blazed and scribed bearing trees: (all measurements taken to a nail in side of tree)

Ash	15"	N 51° E	14.25 feet
Ash	13"	S 34° E	22.39 feet
Sugar Maple	7"	S 02° W	32.87 feet
Steel Sign Post		N 60° W	0.70 feet

PEER GROUP APPROVED


Richard P. Deahn 1/20/94
 COUNTY REPRESENTATIVE

Signed by

Gary L. Pisoni

Date Sept 29, 1993

Surveyor's Michigan License No. 27457

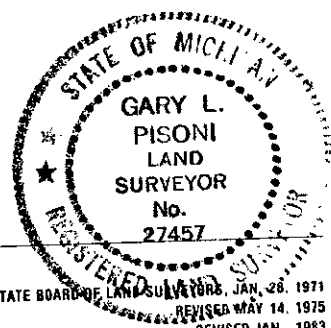

FORM APPROVED BY MICHIGAN STATE BOARD OF LAND SURVEYORS, JAN. 28, 1971
 REVISED MAY 14, 1975
 REVISED JAN., 1983