

LAND CORNER RECORDATION CERTIFICATE
Filing Requirement of Act 74, Mich. P.A. 1970

Register's Office } ss.
Gogebic County }

Received for record this
1st day of JUNE
A. D. 1994 at 1:45 o'clock
P m., and recorded in
Liber 5 of CORNERS
on page 62
Richard J. Brown
Register of Deeds

For corners in
Gogebic
(County)
Located In: Corner Code #
1. Public Land Survey T 44N R 41W G-4, 5
T R 011
T R 011
T R R.L.D.
2. Property Controlling S T R 10/10/98
in Section **PEER GROUP** Approved
3. Miscellaneous S T R Richard L. Pisoni
Property in Sec. 5/25/94
4. Lot No. , Recorded Plat
5. Private Claims

Register of Deeds Stamp & File Number

South Meander corner between Sections 9 and 10 on the North shore of Lindsley Lake

I, Gary L. Pisoni, in a field survey on December 21, 19 93, do hereby certify that under requirements of P.A. 74, Michigan P.A. of 1970, the corner points mentioned in lines 1 and 2 above were in conformance with regulations and rules therefore as required in the current manual of survey instructions of the United States Department of the Interior, Bureau of Land Management or by a decree of a Court of Law and/or that the corner points mentioned in lines 3, 4 and 5 above were in conformance with the rules of the Michigan Board of Land Surveyors or by a Decree of a Court of Law; established, re-established, monumented, re-monumented, recovered, found as expressed below:

	A	B	C	D	E	F	G	H	I	J	K	L	M
2	6	5	4	3	2	1							
3													
4	7	8	9	10	11	12							
5													
6	18	17	16	15	14	13							
7													
8	19	20	21	22	23	24							
9													
10	30	29	28	27	26	25							
11													
12	31	32	33	34	35	36							
13													

NOTE: Not more than 4 corners, all in the same town and range, may be recorded on this certificate.

A. Description of original monument and accessories and/or subsequent restoration:

Original corner: Wood Post
Original Bearing tree:
Balsam 7" East 5 links (3.30 feet)
60.00 CHS. SOUTH


B. Description of corner evidence found and/or method applied in restoring or reestablishing corner:

No original corner evidence found. Corner position found marked by a 1 1/4" x 4" long iron pipe located on the North shore of Lindsley Lake. Iron pipe set by unknown person. I accept the iron pipe as the best available evidence for restoring the corner position. Replaced iron pipe with an aluminum pipe monument as described below. Monument is located 8 feet from waters edge.

C. Description of monument for corner and accessories established to perpetuate locating the position of the corner:

At the corner position, I set a 2" diameter by 30" long split base aluminum pipe monument with a 3" cast aluminum cap, stamped to read: T44N, R41W, S-9, S-10, M.C., 1993, RLS- 27457 from which I established the following new blazed and scribed bearing trees: (all measurements taken to a nail in side of tree)

Balsam	5"	S 09° E	3.56 feet
Balsam	4"	N 25° E	6.04 feet
Balsam	5"	N 48° W	4.90 feet
Steel Sign Post		N 64° E	1.25 feet

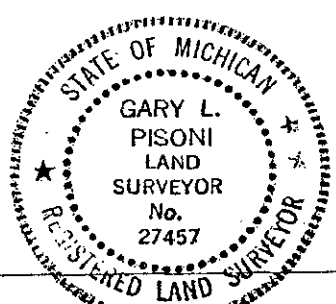

Signed by Gary L. Pisoni Date 4-1-94

Surveyor's Michigan License No. 27457

17