

LAND CORNER MONUMENTS

JAN 20 1999

T. 44 N., R. 41 W.

SECTION

WATERSMEET TOWNSHIP


Index

State

MICH  
WISG.

MICH  
WISG.

Index

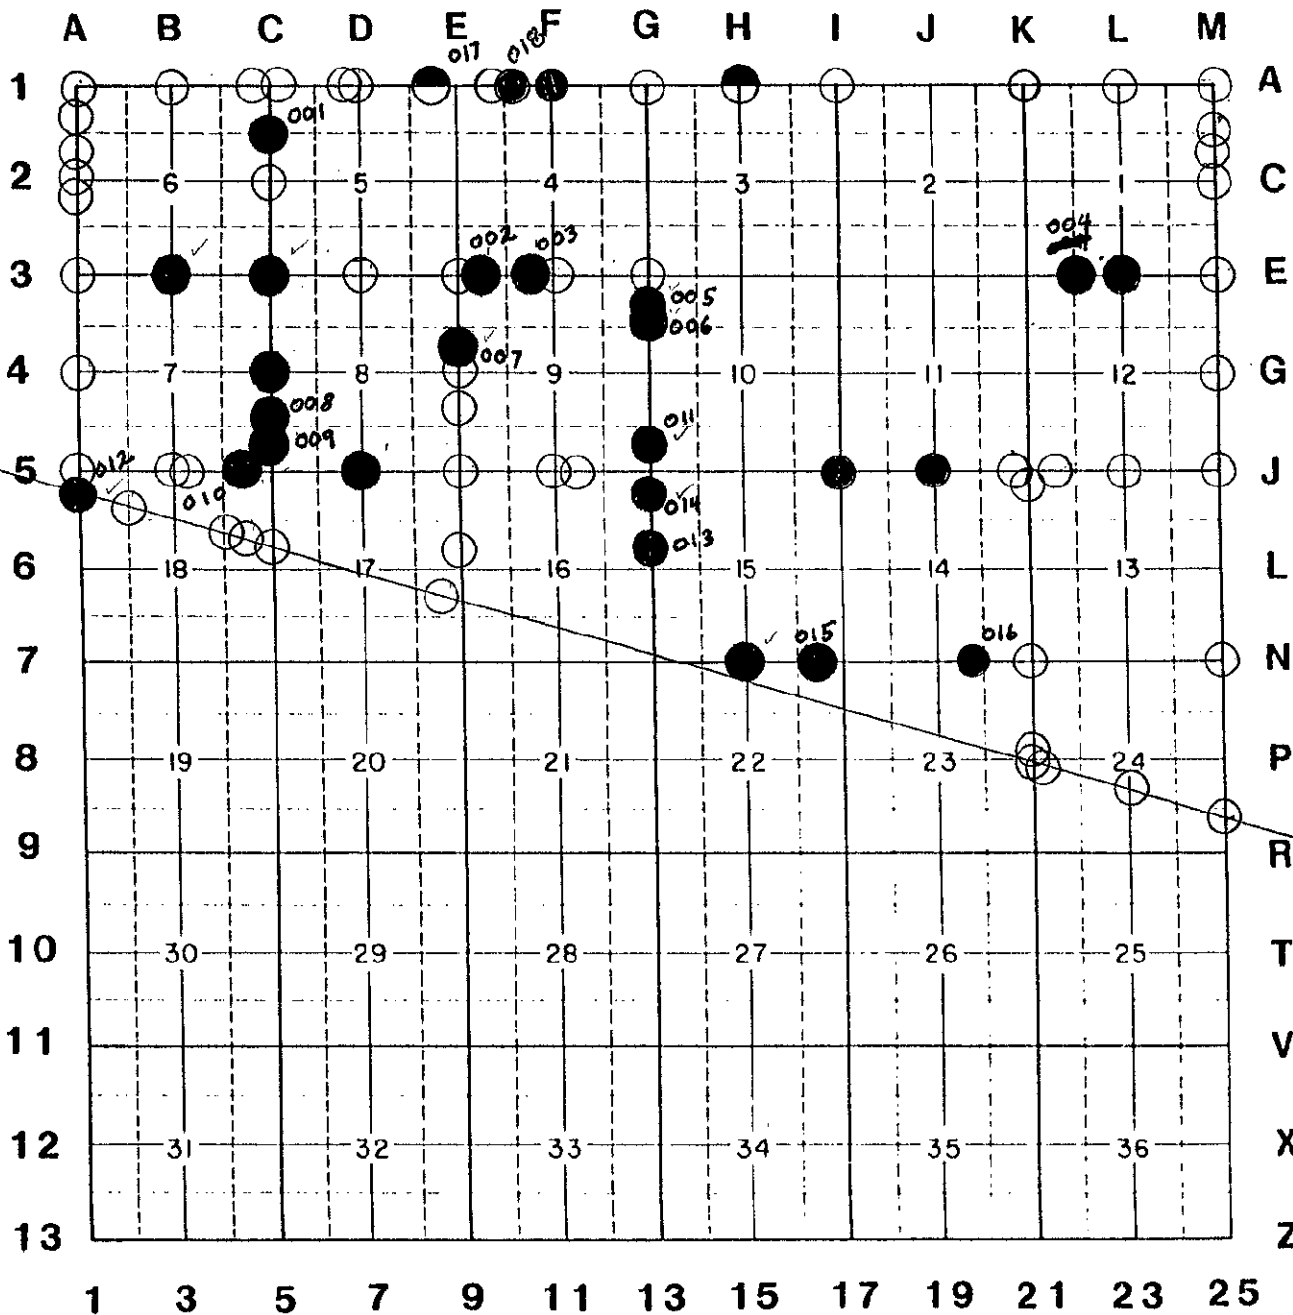

AS OF 12/31/98

LEGEND

Federal

- GLO Corners researched
- ⊙ GLO Corners monumented, not approved
- ⊗ GLO Corners approved
- GLO Corners approved & reported to State

T. 44 N., R. 41 W.