SURVEY &
REMONUMENTATION

JAN 2 2 1998

LAND CORNER RECORDATION CERTIFICATE
Filing Requirement of Act 74, Mich. P.A. 1970

Register's Office } ss.
Gogebic County }

For corners in
Gogebic SECTION
(County)

	Located In:	Corner Code #
1. Public Land Survey	Section 21 45W 39W	E-8
	T___ R___	
	T___ R___	
	T___ R___	
	T___ R___	
2. Property Controlling in Section	S___ T___ R___	
	S___ T___ R___	
3. Miscellaneous Property in Sec.	S___ T___ R___	
	S___ T___ R___	

Received for record the 2ND day of DECEMBER A. D. 1997 at 10:35 o'clock A m., and recorded in Liber 6 of CORNERS on page 276.
Ramona Collins, Deputy
Register of Deeds

Register of Deeds Stamp & File Number

4. Lot No. _____ , Recorded Plat _____
5. Private Claims _____
1/4 corner sections 20 & 21, T45N, R39W

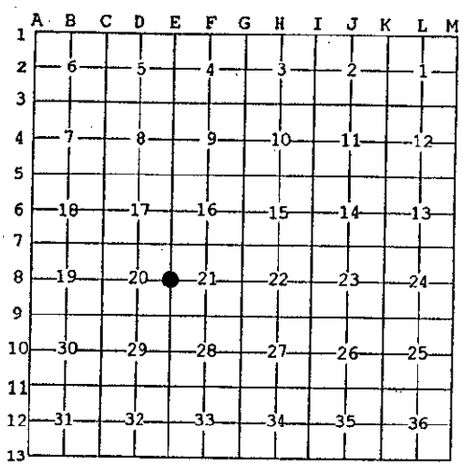

I, John R. Garske, in a field survey on November 13, 97, 19 ___ do hereby state that under requirements of P.A. 74, Michigan P.A. of 1970, the corner points mentioned in lines 1 and 2 above were in conformance with regulations and rules therefore as required in the current manual of survey instructions of the United States Department of the Interior, Bureau of Land Management or by a decree of a Court of Law and /or that the corner points mentioned in lines 3, 4 and 5 above were in conformance with the rules of the Michigan Board of Land Surveyors or by a Decree of a Court of Law; established, re-established, monumented, recovered, found as expressed below:

NOTE: Not more than 2 corners, all in the same town and range, may be recorded on this certificate.

A. Description of original monument and accessories and/or subsequent restoration:

Original survey by Austin Burt, D.S. in 1851. He set a wood post at 40.16 chains running S12°E, from which:
A Cedar 18" N58°E 24 links (15.84 ft.)
A Cedar 10" S25°W 14 links (9.24 ft.)
44.30 chains - enter swamp
53.00 chains - leave swamp
58.00 chains - enter swamp

B. Description of corner evidence found and/or method applied in restoring or reestablishing corner:

I set a mathematical search point based on existing monumented corners in Section 21 and natural feature ties. From the math point I positioned the corner at 61.53 feet east and 5.08 feet south using the decayed remains of the two bearing trees. The 1st is a 20"± cedar wind throw lying on the ground with axe marks and blazes still evident at N58°E, the 2nd is now a stump hole with cedar evident in the root holes. The distance of 283.8 feet north to the swamp checks very good with the original notes from this position.

(Research on file)

PEER GROUP APPROVED
Richard L. Dealn 12/1/97
COUNTY REPRESENTATIVE

C. Description of monument for corner and accessories established to perpetuate locating the position of the corner:

I set a 2 1/2" dia. x 30" long alum. pipe with a 3 1/4" dia. alum. cap stamped to identify the corner, from which I established:

11" Spruce	N60°E	31.04 feet
5" Spruce	S10°W	25.54 feet
7" Balsam	S69°W	54.17 feet
12" Spruce	N24°W	36.04 feet
Steel sign post	North	1.15 feet

Signed by John R Garske
Surveyor's Michigan License No. 28410

Date 11/28/97

STATE OF MICHIGAN
JOHN R. GARSKE
LAND SURVEYOR
No. 28410
LICENSED LAND SURVEYOR

FORM APPROVED BY MICHIGAN STATE BOARD OF PROFESSIONAL SURVEYORS, JAN. 28, 1971
REVISED MAY 14, 1975
REVISED JAN., 1983
REVISED OCT., 1995