

**SURVEY & REMONUMENTATION**

OCT 03 1996

**COMMISSION**

**LAND CORNER RECORDATION CERTIFICATE** Register's Office }  
 Filing Requirement of Act 74, Mich. P.A. 1970 }  
 Goebic County } ss.

For corners in	Goebic	Located In:	Corner Code #
(County)			
1. Public Land Survey	Sec. 15	T 45N R 39W	G-7
		T _____ R _____	_____
		T _____ R _____	_____
		T _____ R _____	_____
2. Property Controlling in Section	S _____	T _____ R _____	_____
	S _____	T _____ R _____	_____
3. Miscellaneous Property in Section	S _____	T _____ R _____	_____
	S _____	T _____ R _____	_____

Received for record the  
28<sup>th</sup> day of MARCH  
 A. D. 1996 at 11:25 o'clock  
A m., and recorded in  
 Liber 5 of CORNERS  
 on page 333  
*Demona Collins, Deputy*  
 Register of Deeds  
 Register of Deeds Stamp & File Number

4. Lot No. \_\_\_\_\_, Recorded Plat \_\_\_\_\_  
 5. Private Claims \_\_\_\_\_

Section corner 15, 16, 21 and 22, T45N, R39W.

I, John R. Garske, in a field survey on January 17, 1996, do hereby certify that under requirements of P.A. 74, Michigan P.A. of 1970, the corner points mentioned in lines 1 and 2 above were in conformance with regulations and rules therefore as required in the current manual of survey instructions of the United States Department of the Interior, Bureau of Land Management or by a decree of a Court of Law and/or that the corner points mentioned in lines 3, 4 and 5 above were in conformance with the rules of the Michigan Board of Professional Surveyors or by a Decree of a Court of Law; established, re-established, monumented, re-monumented, recovered, found as expressed below:

A	B	C	D	E	F	G	H	I	J	K	L	M
2	6	5	4	3	2	1						
3												
4	7	8	9	10	11	12						
5												
6	18	17	16	15	14	13						
7												
8	19	20	21	22	23	24						
9												
10	30	29	28	27	26	25						
11												
12	31	32	33	34	35	36						
13												

**NOTE: Not more than 4 corners, all in the same town and range, may be recorded on this certificate.**

**A. Description of original monument and accessories and/or subsequent restoration:**

- Original survey by Wells Burt, D.S., in 1851. He set a post from which: Spruce 12" - N16°E - 22 links and a maple 16" - S51°W - 39 links
- 1969 - MDOT Highway plans shows corner at Sta. 505+7.82, 41' east of Highway 45 centerline as a 3/4" iron rod in line with R/W monuments. TIES: P. Pole - N32°E - 57.30 feet; 9" elm - S77°W - 39.65 feet; 4" poplar - S75°E - 60.77 feet.
- 1979 Survey by Ewart Muller, RLS 15408, shows a hub at corner.

**B. Description of corner evidence found and/or method applied in restoring or reestablishing corner:**

I was unable to find any remains of the 1979 Muller survey or 1969 MDOT corner location. Muller's survey shows a distance of 2644.52 feet south to the 1/4 corner of Sections 21 and 22 which is recorded. I re-established the corner by using the MDOT plans showing the corner on line with the concrete R/W monuments at 42' off the highway centerline. I measured 2644.97 feet to the found 1/4 corner south and 2634.59 feet north to the re-established 1/4 corner to Sections 15 and 16 and 2623.64 feet east to the recorded 1/4 corner.


(Record Research on File)

PEER GROUP APPROVED  
*Richard L. D... 3/27/96*  
 COUNTY REPRESENTATIVE

**C. Description of monument for corner and accessories established to perpetuate locating the position of the corner:**

I set a 3/4" x 36" long aluminum rod with a 3 1/4" diameter aluminum cap stamped: T45N, R39W, S-16, S-15, S-21 & S-22, 1996, RLS 28410, from which I established the following bearing trees and/or reference objects:

- P. Pole - N29°E - 66.10 feet
- Concrete R/W monument - S81°E - 23.55 feet
- P. Pole - S05°E - 168.41 feet
- Steel sign rail - S02°W - 2.21 feet

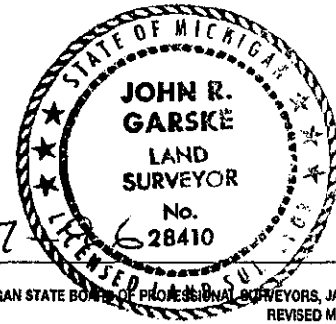

Signed by John R. Garske  
 Surveyor's Michigan License No. 28410

Date 3-7-96

FORM APPROVED BY MICHIGAN STATE BOARD OF PROFESSIONAL SURVEYORS, JAN. 28, 1971  
 REVISED MAY 14, 1975  
 REVISED JAN., 1983