SURVEY & REMONUMENTATION

AUG 0 8 1997

COMMISSION

LAND CORNER RECORDATION CERTIFICATE

Filing Requirement of Act 74, Mich. P.A. 1970

Register's Office } ss.
Gogebic County }

Received for record the 16TH day of JULY A. D. 19 97 at 1:40 o'clock P m., and recorded in Liber 6 of CORNERS on page 156

Colleen M. Richak
Deputy Register of Deeds

Register of Deeds Stamp & File Number

For corners in Gogebic (County)

	Located In:			Corner Code #
1. Public Land Survey	Section 22	T 45N	R 39W	G-9
		T ____	R ____	
		T ____	R ____	
		T ____	R ____	
2. Property Controlling	S ____	T ____	R ____	
in Section	S ____	T ____	R ____	
3. Miscellaneous	S ____	T ____	R ____	
Property in Section	S ____	T ____	R ____	

4. Lot No. _____, Recorded Plat _____
5. Private Claims _____

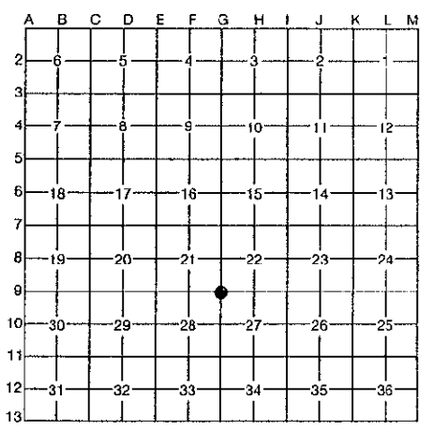

The Section Corner common to Sections 21, 22, 27, 28, T45N, R39W.

I, John R. Garske, in a field survey on June 30, 19 97, do hereby certify that under requirements of P.A. 74, Michigan P.A. of 1970, the corner points mentioned in lines 1 and 2 above were in conformance with regulations and rules therefore as required in the current manual of survey instructions of the United States Department of the Interior, Bureau of Land Management or by a decree of a Court of Law and/or that the corner points mentioned in lines 3, 4 and 5 above were in conformance with the rules of the Michigan Board of Professional Surveyors or by a Decree of a Court of Law; established, re-established, monumented, re-monumented, recovered, found as expressed below:

NOTE: Not more than 4 corners, all in the same town and range, may be recorded on this certificate.

A. Description of original monument and accessories and/or subsequent restoration:

In 1851, Wells Burt, D.S., established the corner and following bearing trees:
8" White Birch N44°E 12 links
36" White Pine S25°W 4 links

In 1965, Donald Lappala R.L.S. #12585, reestablished the corner from railroad right-of-way plans and Michigan State Highway plans for U.S. 45. He established accessories as noted in Section C below.
Record Liber 1, page 139.

B. Description of corner evidence found and/or method applied in restoring or reestablishing corner:

I found a corner monument with brass cap 1' below the surface as noted in Lapplas Certificate. I established new accessories as indicated below.

(Record Research on file)

PEER GROUP APPROVED
Richard P. Drake 7/15/97
COUNTY REPRESENTATIVE

C. Description of monument for corner and accessories established to perpetuate locating the position of the corner:

Witness corner monument -west -26.44 ft. (existing)		
NE corner of house	N50°W	72.41 ft. (new)
9" Red Pine	S23°W	76.47 ft. (new)
PP # N651228	N60°E	119.53 ft. (new)

I placed a 3/4" x 1' Iron Rod flush with the surface over the corner monument.

STATE OF MICHIGAN
JOHN R. GARSKE
LAND SURVEYOR
No. 28410
LICENSED LAND SURVEYOR

Signed by John R Garske Date 7/15/97

Surveyor's Michigan License No. 28410

FORM APPROVED BY MICHIGAN STATE BOARD OF PROFESSIONAL SURVEYORS, JAN. 28, 1971
REVISED MAY 14, 1975
REVISED JAN., 1983