

SURVEY & REMONUMENTATION

NOV 12 1997

COMMISSION

LAND CORNER RECORDATION CERTIFICATE
Filing Requirement of Act 74, Mich. P.A. 1970

Register's Office }
Gogebic County } ss.

For corners Gogebic
(County)

Located In: _____ Corner Code # _____

1. Public Land Survey	T <u>45N</u> _____	R <u>39W</u> _____	G-11
	T _____	R _____	
	T _____	R _____	
	T _____	R _____	
2. Property Controlling in Section	S _____	T _____	R _____
	S _____	T _____	R _____
3. Miscellaneous Property in Section	S _____	T _____	R _____
	S _____	T _____	R _____

4. Lot No. _____, Recorded Plat _____

5. Private Claims _____

Received for record the
18TH day of AUGUST
A. D. 1997 at 11:00 o'clock
A M., and recorded in
Liber 6 of CORNERS
on page 175
Ramona Collins, Deputy
Register of Deeds


Register of Deeds Stamp & File Number

The Section Corner common to Sections 27, 28, 33, and 34, T45N, R39W.

John R. Garske June 30 97

I, _____, in a field survey on _____, 19 _____, do hereby certify that under requirements of P.A. 74, Michigan P.A. of 1970, the corner points mentioned in lines 1 and 2 above were in conformance with regulations and rules therefore as required in the current manual of survey instructions of the United States Department of the Interior, Bureau of Land Management or by a decree of a Court of Law and/or that the corner points mentioned in lines 3, 4 and 5 above were in conformance with the rules of the Michigan Board of Professional Surveyors or by a Decree of a Court of Law; established, re-established, monumented, re-monumented, recovered, found as expressed below:

NOTE: Not more than 4 corners, all in the same town and range, may be recorded on this certificate.

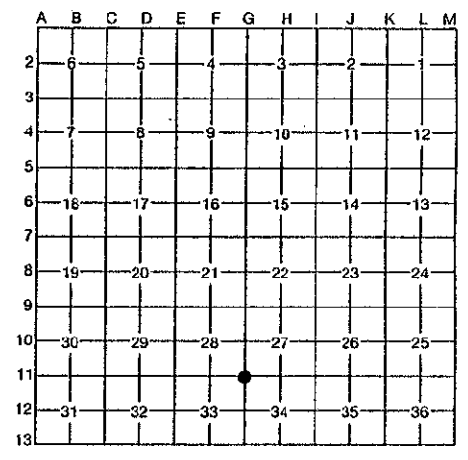

A. Description of original monument and accessories and/or subsequent restoration:

Corner established by Wells Burt, D.S., in 1851. Original bearing trees:
14" Cedar -N42°W 22 links
14" Cedar -S43°E 36 links

In 1972 Donald Lappala R.L.S. # 12585 set a galvanized pipe and brass cap as a reference monument. He established accessories as noted in Section C below. Corner was recorded Dec. 9 1974, Liber 1, page 57 and 58.

B. Description of corner evidence found and/or method applied in restoring or reestablishing corner:


I found an 1 1/2" Iron pipe 1' below the gravel surface of the west shoulder of Hwy. U.S. 45, 16.90' ^{from} of the centerline of the highway.
Bearing trees and reference objects are noted in Section C below.

(Record Research on file)

PEER GROUP APPROVED
Richard L. Drake 8/13/97
COUNTY REPRESENTATIVE

C. Description of monument for corner and accessories established to perpetuate locating the position of the corner:

- 8" Tamarack N86°W 52.43 ft. (existing)
- 5" Cedar N51°W 64.68 ft. (existing)
- 7" Cedar S68°W 58.46 ft. (existing)
- 4"x4"x7' Cedar sign post -East 40.25 ft. (existing)
- 9" Tamarack N86°E 56.65 ft. (new)

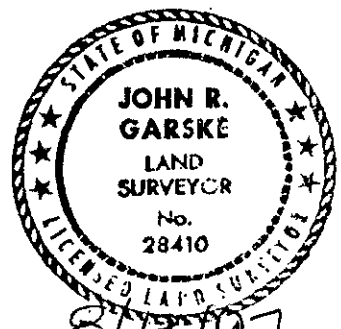

Signed by John R. Garske
Surveyor's Michigan License No. 28410

Date 8/13/97