

# SURVEY & REMONUMENTATION

OCT 03 1996

## LAND CORNER RECORDATION CERTIFICATE Filing Requirement of Act 74, Mich. P.A. 1970

Register's Office }  
Gogebic County } ss.

For corners in COMMISSION  
Gogebic  
(County)

Located In:

Corner Code #

- |                                      |         |              |              |            |
|--------------------------------------|---------|--------------|--------------|------------|
| 1. Public Land Survey                | Sec. 15 | T <u>45N</u> | R <u>39W</u> | <u>H-5</u> |
|                                      |         | T _____      | R _____      | _____      |
|                                      |         | T _____      | R _____      | _____      |
|                                      |         | T _____      | R _____      | _____      |
| 2. Property Controlling in Section   | S _____ | T _____      | R _____      | _____      |
|                                      | S _____ | T _____      | R _____      | _____      |
| 3. Miscellaneous Property in Section | S _____ | T _____      | R _____      | _____      |
|                                      | S _____ | T _____      | R _____      | _____      |
4. Lot No. \_\_\_\_\_, Recorded Plat \_\_\_\_\_
5. Private Claims \_\_\_\_\_

Received for record the  
28<sup>TH</sup> day of MARCH

A. D. 1996 at 11:25 o'clock

A m., and recorded in

Libor 5 of CORNERS

on page 335

Ramona Collins Deputy  
Register of Deeds

Register of Deeds Stamp & File Number

One-quarter corner Sections 10 and 15, T45N, R39W

I, John R. Garske, in a field survey on January 2, 19 96, do hereby certify that under requirements of P.A. 74, Michigan P.A. of 1970, the corner points mentioned in lines 1 and 2 above were in conformance with regulations and rules therefore as required in the current manual of survey instructions of the United States Department of the Interior, Bureau of Land Management or by a decree of a Court of Law and/or that the corner points mentioned in lines 3, 4 and 5 above were in conformance with the rules of the Michigan Board of Professional Surveyors or by a Decree of a Court of Law; established, re-established, monumented, re-monumented, recovered, found as expressed below:

A	B	C	D	E	F	G	H	I	J	K	L	M
2	6	5	4	3	2	1						
3												
4	7	8	9	10	11	12						
5				●								
6	18	17	16	15	14	13						
7												
8	19	20	21	22	23	24						
9												
10	30	29	28	27	26	25						
11												
12	31	32	33	34	35	36						
13												

**NOTE: Not more than 4 corners, all in the same town and range, may be recorded on this certificate.**

**A. Description of original monument and accessories and/or subsequent restoration:**

- Original survey by Wells Burt, D.S., who set a wooden post from which he established: 14" tamarack - N16°E - 13 links and a 8" spruce - 53°W - 28 links.
- 1945 - MDOT Highway plans for a reroute of M-45 shows a 3" square cedar post at corner location with bearing trees: 6" tamarack - S25°E - 10.78 feet; 7" pine - S45°W - 14.61 feet; 5" tamarack - N40°W - 46.10 feet

**B. Description of corner evidence found and/or method applied in restoring or reestablishing corner:**

I found a 3"± squared 4' long cedar stake in a moss covered bog area. A finishing nail is in the top of the stake with a blazed 8" tamarack bearing N86°W - 36.12 feet. A 7" dead blazed spruce bears S57°W - 15.0 feet. This post location has been used and accepted by other surveyors for over 25 years, as per my discussions with other area surveyors. Measurements to available corners west and east check reasonably well as does the original swamp call west of 253.44 feet. I am accepting this post as the most probable location of the original corner.


(Record Research on File)

PEER GROUP APPROVED  
Richard L. Drach 3/27/96  
COUNTY REPRESENTATIVE

**C. Description of monument for corner and accessories established to perpetuate locating the position of the corner:**

I set a 3/4" diameter x 48" long aluminum rod with a 3 1/4" diameter aluminum cap stamped: T45N, R39W, S-10, S-15, 1/4 cor., 1995, RLS 28410, from which I established the following bearing trees and/or reference objects:

- 6" tamarack - N86°W - 36.12 feet (found)
- Power pole - N32°E - 83.25 feet
- Steel sign post - S50°E - 2.73 feet
- Steel sign post - N21°W - 4.15 feet

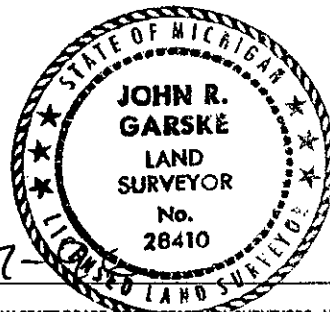

Signed by John R. Garske

Date 3-7-

Surveyor's Michigan License No. 28410

FORM APPROVED BY MICHIGAN STATE BOARD OF PROFESSIONAL SURVEYORS, JAN. 28, 1971  
REVISED MAY 14, 1975  
REVISED JAN., 1983