

**SURVEY & REMONUMENTATION**

OCT 03 1996

**LAND CORNER RECORDATION CERTIFICATE**  
**Filing Requirement of Act 74, Mich. P.A. 1970**

Register's Office }  
 Gogebic County } ss.

COMMISSION  
 For corners in Gogebic  
 (County)

Located In:

Corner Code #

Received for record the  
28<sup>TH</sup> day of MARCH  
 A. D. 1996 at 11:25 o'clock  
A m., and recorded in  
 Liber 5 of CORNERS

on page 336  
*Ramona Collins* Deputy  
 Register of Deeds

Register of Deeds Stamp & File Number

1. Public Land Survey	Sec. 15	T <u>45N</u> R <u>39W</u>	<u>H-7</u>
		T _____ R _____	_____
		T _____ R _____	_____
		T _____ R _____	_____
2. Property Controlling in Section	S _____	T _____ R _____	_____
	S _____	T _____ R _____	_____
3. Miscellaneous Property in Section	S _____	T _____ R _____	_____
	S _____	T _____ R _____	_____

4. Lot No. \_\_\_\_\_, Recorded Plat \_\_\_\_\_  
 5. Private Claims \_\_\_\_\_

One-quarter cor. Sections 15 and 22, T45N, R39W.

I, John R. Garske, in a field survey on January 17, 19 96, do hereby certify that under requirements of P.A. 74, Michigan P.A. of 1970, the corner points mentioned in lines 1 and 2 above were in conformance with regulations and rules therefore as required in the current manual of survey instructions of the United States Department of the Interior, Bureau of Land Management or by a decree of a Court of Law and/or that the corner points mentioned in lines 3, 4 and 5 above were in conformance with the rules of the Michigan Board of Professional Surveyors or by a Decree of a Court of Law; established, re-established, monumented, re-monumented, recovered, found as expressed below:

**NOTE: Not more than 4 corners, all in the same town and range, may be recorded on this certificate.**

A	B	C	D	E	F	G	H	I	J	K	L	M
2	6	5	4	3	2	1						
3												
4	7	8	9	10	11	12						
5												
6	18	17	16	15	14	13						
7												
8	19	20	21	22	23	24						
9												
10	30	29	28	27	26	25						
11												
12	31	32	33	34	35	36						
13												

**A. Description of original monument and accessories and/or subsequent restoration:**

- Original survey by Wells Burt, D.S., in 1851. He set a post from which a: Cedar 10" - N01°W - 5 links and a tamarack 12" - S31°E - 14 links.
- Neil Spherhake, RLS, set an iron pipe at the 1/4 corner while working for Champion Timberlands, date unknown.
- 1979 - Ewart Muller found Spherhake's pipe and recorded it in L5, pg. 57 of land corners on 3-10-80. He established the following BT's: 8" cedar - N28°E - 16.68 feet and a 12" cedar - S36°E - 9.45 feet.

**B. Description of corner evidence found and/or method applied in restoring or reestablishing corner:**

I found the iron pipe as noted by Muller. A wooden post was lying next to the pipe. An old yellow tag bears S60°E - 12 feet, on a dead cedar. I found Muller's bearing trees and confirmed the pipe's position.


(P.A. 74 Research on File)

**PEER GROUP APPROVED**  
*Richard L. Walsh* 3/27/96  
 COUNTY REPRESENTATIVE

**C. Description of monument for corner and accessories established to perpetuate locating the position of the corner:**

I replaced the found iron pipe with a 2 1/2" diameter x 36" long aluminum pipe monument with a 3 1/4" diameter aluminum cap stamped: T45N, R39W, 1/4 cor., S-15, S-16, 1996, RLS 28410, from which I established the following bearing trees and/or reference objects:

- 12" cedar - N36°E - 16.50 feet (existing)
- 16" cedar - S36°E - 9.45 feet (existing)
- 12" cedar - N61°W - 23.88 feet
- 6' steel sign rail - S60°W - 1.54 feet

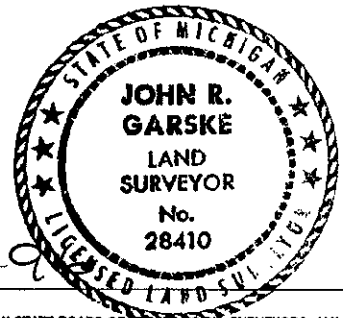

Signed by *John R. Garske*  
 Surveyor's Michigan License No. 28410

Date 3-7-96