

**SURVEY & REMONUMENTATION**

AUG 08 1997

**COMMISSION**

**LAND CORNER RECORDATION CERTIFICATE**  
**Filing Requirement of Act 74, Mich. P.A. 1970**

For corners in Cochebic  
 (County)

Located In:

Corner Code #

1. Public Land Survey	Section 10	45N	39W	I-5
	T		R	
	T		R	
	T		R	
2. Property Controlling in Section	S		R	
	S	T	R	
3. Miscellaneous Property in Section	S	T	R	
	S	T	R	

4. Lot No. \_\_\_\_\_, Recorded Plat \_\_\_\_\_  
 5. Private Claims \_\_\_\_\_

The Section Corner common to Sections 10, 11, 14, 15, T45N, R39W.

John R. Garske June 30 97

I, \_\_\_\_\_, in a field survey on \_\_\_\_\_, 19\_\_\_\_\_, do hereby certify that under requirements of P.A. 74, Michigan P.A. of 1970, the corner points mentioned in lines 1 and 2 above were in conformance with regulations and rules therefore as required in the current manual of survey instructions of the United States Department of the Interior, Bureau of Land Management or by a decree of a Court of Law and/or that the corner points mentioned in lines 3, 4 and 5 above were in conformance with the rules of the Michigan Board of Professional Surveyors or by a Decree of a Court of Law; established, re-established, monumented, re-monumented, recovered, found as expressed below:

**NOTE: Not more than 4 corners, all in the same town and range, may be recorded on this certificate.**

**A. Description of original monument and accessories and/or subsequent restoration:**

In September, 1851, Wells Burt, D.S., set a post and established the following bearing trees:  
 20" Hemlock -S46°W 14 links  
 14: Cedar -N11°E 24 links

1945-MDOT Hwy. Plans- Tag in 12" poplar -S40°E -8.92'  
 4" Balsam -N70°W -7.90'  
 3" Cedar -S60°W -14.16'  
 Found a 3" Cedar Post

**B. Description of corner evidence found and/or method applied in restoring or reestablishing corner:**

I found an old squared wooden post at the corner location as noted in the 1945 Hwy. Plans and an old rotted 4" Spruce with a tree tag/location poster. The location is consistent with natural feature ties and checks with the 1945 Hwy. Plans. Corner is 2619.20 ft. ~~west~~ <sup>east</sup> of 1/4 corner to 10 and 15.


(Record Research on file)

**PEER GROUP APPROVED**  
*Richard L. Drahm 7/15/97*  
**COUNTY REPRESENTATIVE**

**C. Description of monument for corner and accessories established to perpetuate locating the position of the corner:**

I set a 3/4" x 4" aluminum rod with a 3 1/4" diameter aluminum cap stamped to read: County Remonumentation, T45N, R39W, 10, 11, 14, 15, 1997, R.L.S. 28410.  
 I established the following bearing trees and reference objects:

5" S. Maple	North	10.35 ft.
8" S. Maple	N67°E	14.19 ft.
12" S. Maple	S59°E	31.61 ft.
Steel sign post	S60°W	1.59 ft.

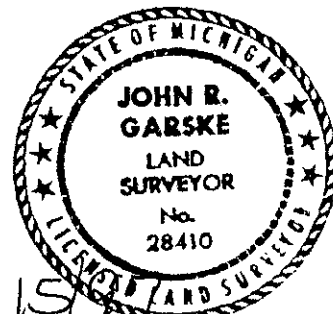

Signed by John R. Garske  
 Surveyor's Michigan License No. 28410

Date 7/15/97

Register's Office }  
 Cochebic County } ss.  
 Received for record the  
16<sup>th</sup> day of JULY  
 A. D. 1997 at 1:40 o'clock  
P m., and recorded in  
 Lib. 6 of CORNERS  
 on page 157  
*Colleen M. Kibak*  
 Deputy Register of Deeds  
 Register of Deeds Stamp & File Number

