

LAND CORNER MONUMENTS

JAN 20 1999


T. 45 N., R. 40 W.

SECTION

WATERSMEET TOWNSHIP.

Index

ONTONAGON COUNTY

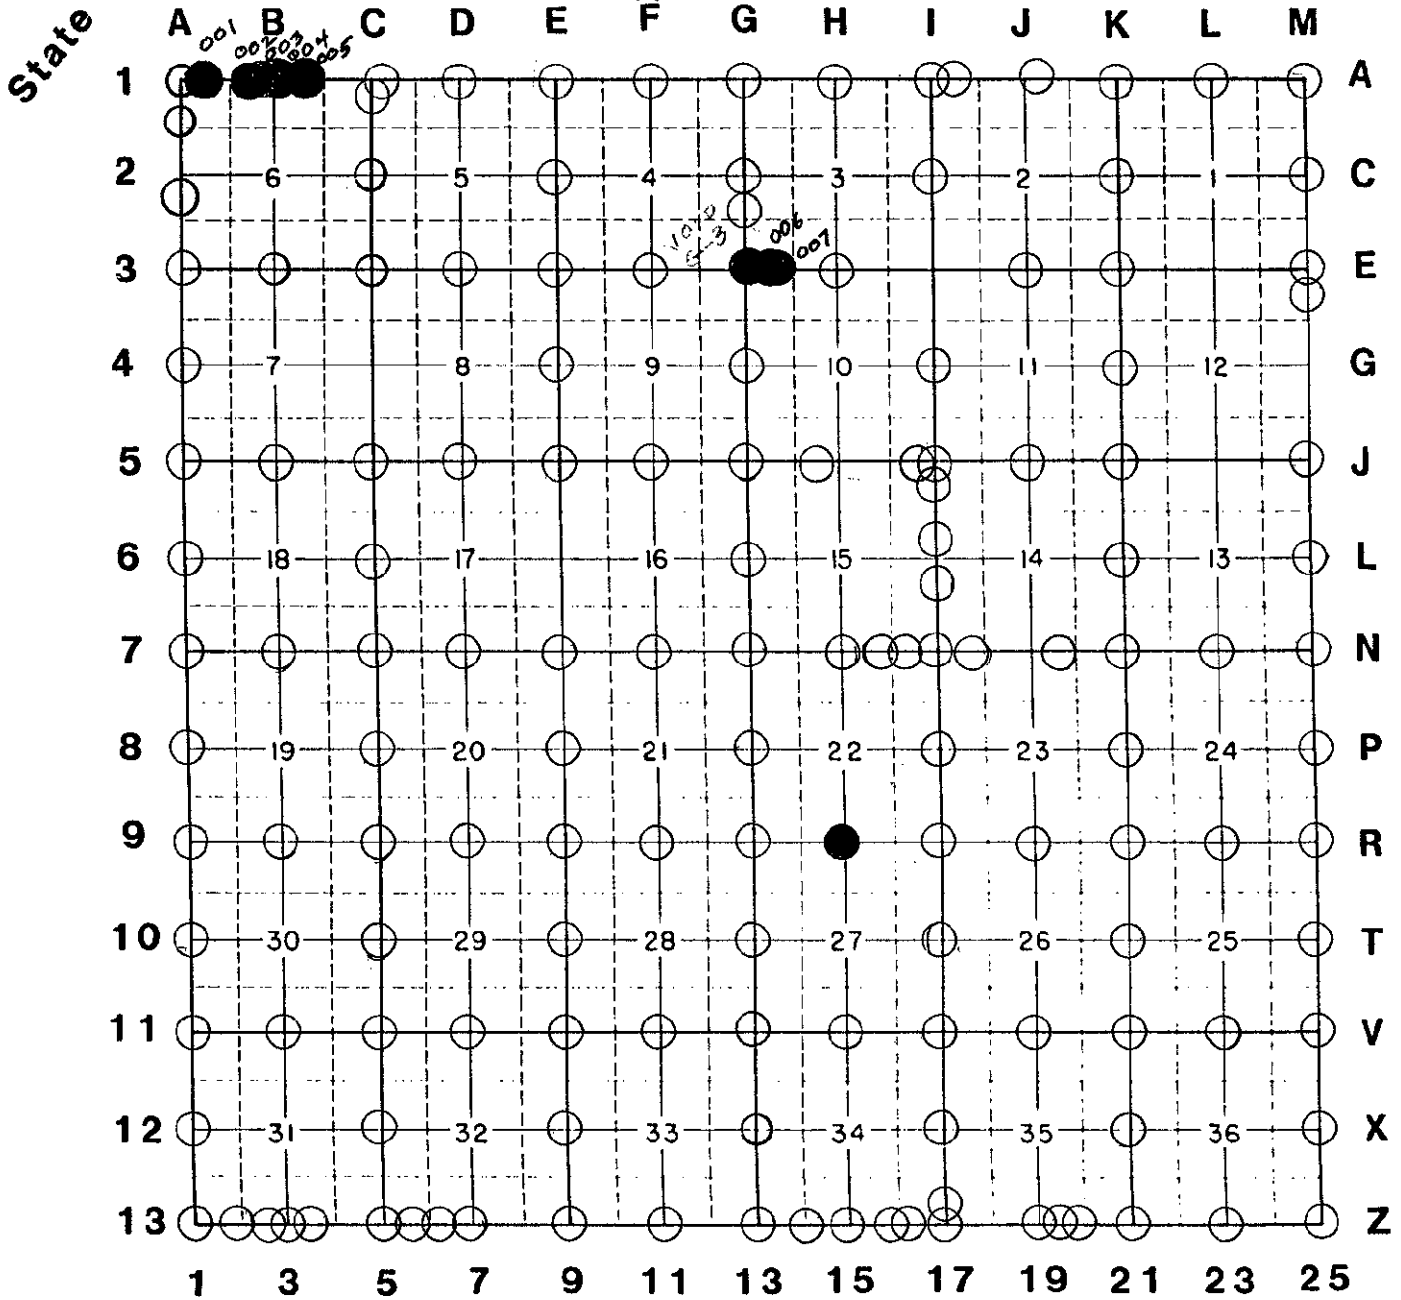

AS OF 12/31/98

LEGEND

Federal Index

- GLO Corners researched
- ⊙ GLO Corners monumented, not approved
- ⊗ GLO Corners approved
- GLO Corners approved & reported to State

T. 45 N., R. 40 W.