

MAR 02 2000

SECTION

LAND CORNER RECORDATION CERTIFICATE
Filing Requirement of Act 74, Mich. P.A. 1970

Register's office }
Gogebic County } ss.

Received for record the
21ST day of JULY
A. D. 1999 at 1:05 o'clock
P m., and recorded in
Liber 7 of CORNERS
on page 170
Romona Collins Deputy
Register of Deeds

Register of Deeds Stamp & File Number

For corners in
Gogebic
(County)

Located in:	Corner Code #
Section 29 45N 41W D-11	
T R	
T R	
T R	
T R	
S T R	
S T R	
S T R	
S T R	

1. Public Land Survey

2. Property Controlling in Section


3. Miscellaneous Property in Sec.

4. Lot No. _____, Recorded Plat _____
5. Private Claims _____

1/4 Corner common to sections 29, 32, T45N, R41W

I, John R. Garske in a field survey on February 16, 1999 state that under requirements of P.A. 74, Michigan P.A. of 1970, the corner points mentioned in lines 1 and 2 above were in conformance with regulations and rules therefore as required in the current manual of survey instructions of the United States Department of the Interior, Bureau of Land Management or by a decree of a Court of Law and for that the corner points mentioned in lines 3, 4 and 5 above were in conformance with the rules of the Michigan Board of Land Surveyors or by a Decree of a Court of Law; established, re-established, monumented, recovered, found as expressed below:

NOTE: Not more than 2 corners, all in the same town and range, may be recorded on this certificate.

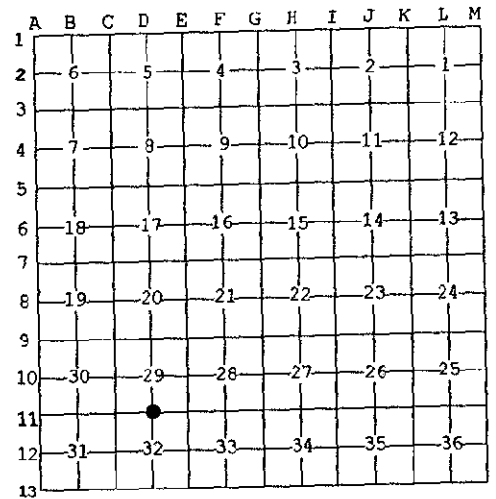

A. Description of original monument and accessories and/or subsequent restoration:

Original survey by A. Merryweather, D.S., June 21, 1852.
Original Bearing Trees: - 10" hemlock N25°W 27 links (17.82 feet)
8" birch S25°E 7 links (4.62 feet)

1975-William Donnan RLS #17168 placed a 5/8" drill rod and established:
12" balsam S08°W 6.73 feet
4" balsam S70°W 22.00 feet
4" balsam N48°W 12.27 feet

1991-Richard Drahn, RLS #21564, found Donnan's 5/8" drill rod in the center, of a 1 1/2" iron pipe, and replaced over the top with a 2" diameter by 30' long split base aluminum monument with a 3 1/4" aluminum cap from which:

8" aspen N23°W 23.45 feet
8" aspen S61°W 12.32 feet
5" balsam S29°W 23.89 feet
6" steel rail north 1.75 feet (corner recorded liber 3, page 401)

B. Description of corner evidence found and/or method applied in restoring or reestablishing corner:

I found the monument and accessories as described by Richard Drahn, all in good condition. I set nails in all the trees and recorded new ties as noted below.


(Research on file)

NEED GROUP APPROVAL
Richard L. Drahn 7/20/99
COUNTY REGISTER

C. Description of monument for corner and accessories established to perpetuate locating the position of the corner:

Monument found as described above from which I established the following witnesses:

steel sign rail	north	1.72 feet (existing) (1.75')
8" balsam	S29°W	23.85 feet (existing) (23.89')
10" aspen	N21°W	23.42 feet (existing) (23.45')
7" aspen	S60°E	12.36 feet (new)
5" balsam	N26°E	11.91 feet (new)

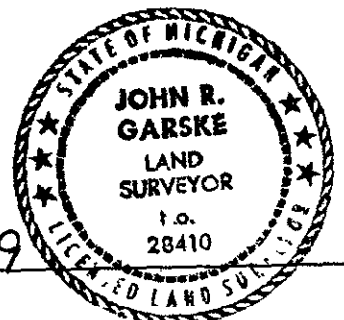

Signed by John R. Garske
Surveyor's Michigan license No. 28410

Date 7/20/99