

**SURVEY & REMONUMENTATION**

AUG 08 1997

**COMMISSION**

**LAND CORNER RECORDATION CERTIFICATE**  
**Filing Requirement of Act 74, Mich. P.A. 1970**

For corners in Gogebic  
 (County)

Located In:

Corner Code #

1. Public Land Survey	Section 2	T 45N	R 41W	G-11
		T	R	
		T	R	
		T	R	
2. Property Controlling in Section	S	T	R	
	S	T	R	
3. Miscellaneous Property in Section	S	T	R	
	S	T	R	

Register's Office } ss.  
 Gogebic County }

Received for record the  
16<sup>TH</sup> day of JULY  
 A. D. 1997 at 1:40 o'clock  
P m., and recorded in  
 Liber 6 of CORNER  
 on page 161  
*Calleen M. Kieba*  
 Deputy, Register of Deeds

Register of Deeds Stamp & File Number

4. Lot No. \_\_\_\_\_, Recorded Plat \_\_\_\_\_  
 5. Private Claims \_\_\_\_\_

Section Corner common to sections 27, 28, 33 and 34 T45N R41W.

John R. Garske June 17 97

I, \_\_\_\_\_, in a field survey on \_\_\_\_\_, 19\_\_\_\_\_, do hereby certify that under requirements of P.A. 74, Michigan P.A. of 1970, the corner points mentioned in lines 1 and 2 above were in conformance with regulations and rules therefore as required in the current manual of survey instructions of the United States Department of the Interior, Bureau of Land Management or by a decree of a Court of Law and/or that the corner points mentioned in lines 3, 4 and 5 above were in conformance with the rules of the Michigan Board of Professional Surveyors or by a Decree of a Court of Law; established, re-established, monumented, re-monumented, recovered, found as expressed below:

**NOTE: Not more than 4 corners, all in the same town and range, may be recorded on this certificate.**

A	B	C	D	E	F	G	H	I	J	K	L	M
2	6	5	4	3	2	1						
3												
4	7	8	9	10	11	12						
5												
6	18	17	16	15	14	13						
7												
8	19	20	21	22	23	24						
9												
10	30	29	28	27	26	25						
11												
12	31	32	33	34	35	36						
13												

**A. Description of original monument and accessories and/or subsequent restoration:**

On June 14, 1852, A. Merry Weather established the corner with the following bearing trees:  
 18" Hemlock N33°W 22 links  
 12" Hemlock S32°E 36 links

In 1990 Richard Drahn R.L. S. #21564 reestablished the corner using 1901 railroad plans and established accessories noted in Section C below. He recorded the corner in Liber 3, page 293.

**B. Description of corner evidence found and/or method applied in restoring or reestablishing corner:**


I found a galvanized pipe with 3" brass tablet and bearing trees (see Section C below), as noted in Drahn's certificate, all bearing trees are in good condition. I established one new bearing tree as noted below.

Corner research on file.

**C. Description of monument for corner and accessories established to perpetuate locating the position of the corner:**

- 7" Black Ash - N25°W - 6.39 feet (existing)
- 9" Cedar -S77°E -49.14 feet (existing)
- 10" Hemlock -S88°W -29.65 feet (existing)
- 6' Steel sign post -S42°W -2.25 feet (existing)
- 8" Cedar -S20°W -36.31 feet (new)

PEER GROUP APPROVED  
*Richard R. Drahn 7/15/97*  
 COUNTY REPRESENTATIVE

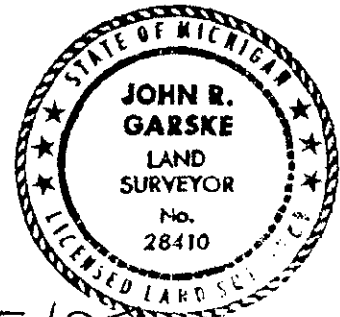

Signed by John R. Garske  
 Surveyor's Michigan License No. 28410

Date 7/15/97