

**SURVEY &  
REMONUMENTATION**

AUG 08 1997

COMMISSION

**LAND CORNER RECORDATION CERTIFICATE  
Filing Requirement of Act 74, Mich. P.A. 1970**

Register's Office }  
Gogebic County } ss.

For corners in Gogebic Located in: \_\_\_\_\_ Corner Code # \_\_\_\_\_  
(County)

- |                                      |            |   |     |   |     |      |
|--------------------------------------|------------|---|-----|---|-----|------|
| 1. Public Land Survey                | Section 33 | T | 45N | R | 41W | G-12 |
|                                      |            | T |     | R |     |      |
|                                      |            | T |     | R |     |      |
|                                      |            | T |     | R |     |      |
| 2. Property Controlling in Section   | S          | T |     | R |     |      |
|                                      | S          | T |     | R |     |      |
| 3. Miscellaneous Property in Section | S          | T |     | R |     |      |
|                                      | S          | T |     | R |     |      |

Received for record the  
16<sup>th</sup> day of JULY

A. D. 1997 at 1:40 o'clock

P m., and recorded in

Liber 6 of CORNERS

on page 162

Colleen M. Kichak  
Deputy Register of Deeds

Register of Deeds Stamp & File Number

4. Lot No. \_\_\_\_\_, Recorded Plat \_\_\_\_\_

5. Private Claims One-quarter corner corner common to sections 33 and 34 T45N, R41W

John R. Garske June 17 97

I, \_\_\_\_\_, in a field survey on \_\_\_\_\_, 19\_\_\_\_\_, do hereby certify that under requirements of P.A. 74, Michigan P.A. of 1970, the corner points mentioned in lines 1 and 2 above were in conformance with regulations and rules therefore as required in the current manual of survey instructions of the United States Department of the Interior, Bureau of Land Management or by a decree of a Court of Law and/or that the corner points mentioned in lines 3, 4 and 5 above were in conformance with the rules of the Michigan Board of Professional Surveyors or by a Decree of a Court of Law; established, re-established, monumented, re-monumented, recovered, found as expressed below:

A	B	C	D	E	F	G	H	I	J	K	L	M
2	6	5	4	3	2	1						
3												
4	7	8	9	10	11	12						
5												
6	18	17	16	15	14	13						
7												
8	19	20	21	22	23	24						
9												
10	30	29	28	27	26	25						
11												
12	31	32	33	34	35	36						
13												

**NOTE: Not more than 4 corners, all in the same town and range, may be recorded on this certificate.**

A. Description of original monument and accessories and/or subsequent restoration:

On June 14, 1852, A. Merry Weather D.S., set a wood post from which a  
6" cedar N55°W 9 links  
10" Tamarack 558°E 18 links  
December 17, 1991 Gary Pisoni R.L.S. #27457 restored the corner and established bearing trees.  
(see section C below). He recorded the corner in Liber 4, page 137.

B. Description of corner evidence found and/or method applied in restoring or reestablishing corner:


I found a 3" aluminum cap and bearing trees in good condition as noted by Pisoni. I established one new bearing tree as noted below.

Corner research on file.

PEER GROUP APPROVED  
Richard P. Drahm 7/15/97  
COUNTY REPRESENTATIVE

C. Description of monument for corner and accessories established to perpetuate locating the position of the corner:

Tamarack 5" N88°E 11.41' 11.50 measured (existing)  
Tamarack 10" S05°W 38.96' (existing)  
Spruce 11" N50°W 53.56 (existing)  
Steel post S28°E 0.85' 0.80 measured  
spruce 3" S22°E 9.50' (new)

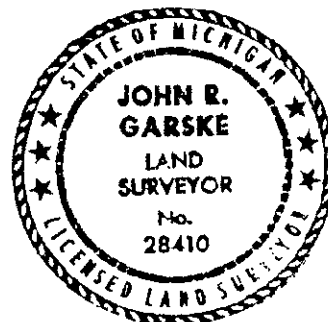

Signed by John R. Garske  
Surveyor's Michigan License No. 28410

Date 7/15/97